

# Registration Statement

## OF CLAIMANT OF RIGHT TO APPROPRIATE GROUND WATER

TO THE STATE ENGINEER OF OREGON:

I, Rudolph Zistel  
of RT 4 Box 29 Salem County of Marion  
(Mailing address)  
State of Oregon, do hereby make application for a certificate of registration as evidence of a right to appropriate ground water.

- Source from which water is withdrawn is drilled well  
(Flowing well, pump well, infiltration trench, or tunnel)
- Location is: 5 1/2 miles S.E. of Salem Oregon  
(Approximate distance and direction from nearest city or town)

and is more particularly described as follows:

(a) 120 rods S. of the NW Section Line and 40 rods E.  
(Give distance and bearing to corner of section or other legal subdivision)  
being within SW 1/4 of NW 1/4 of Sec. 18, Twp. 8 S, Rge. 2 W  
(Smallest legal subdivision) (N. or S.) (E. or W.)  
or (b) within limits of recorded platted property, town or city:  
in Lot 10, Block \_\_\_\_\_ of Hanshaw Fruit Farms  
(Name of plat or addition)  
County of Marion  
(If within city or town, give name)

3. Construction Work was begun on unk; was completed on May 1947  
(Date) (Date)  
and the ground water claimed was first used for the purposes set out below on May 1947  
(Date)  
since which time the water has been used during Summer months  
(Continuously or Intermittently)  
from May to September each year.  
(Date) (Date)

4. Quantity of water claimed and used is 100 gallons per minute; 0 acres irrigated  
0 acre feet per year.

5. Purpose or Purposes for which water is used irrigation for cropland  
(Domestic, Irrigation, municipal, manufacturing, industrial, etc.)

6. Description of Well: Depth 100 feet. Type drilled  
(Dug or drilled)  
diameter 12 inches. Elevation of ground at well site 295 feet, mean sea level.  
(As near as known)  
Depth to water table 4 feet.


7. Capacity of Well: \_\_\_\_\_ g.p.m. with \_\_\_\_\_ feet drawdown.  
\_\_\_\_\_ g.p.m. with \_\_\_\_\_ feet drawdown.

Date of test \_\_\_\_\_  
If Flowing Well: Measured discharge \_\_\_\_\_ g.p.m. on \_\_\_\_\_  
(Date)  
Shut-in pressure at ground surface \_\_\_\_\_ lbs. per sq. in. on \_\_\_\_\_  
(Date)  
Water is controlled by \_\_\_\_\_  
(Cap. valve, etc.)





Township 8 S Range 2 W W.M.  
North

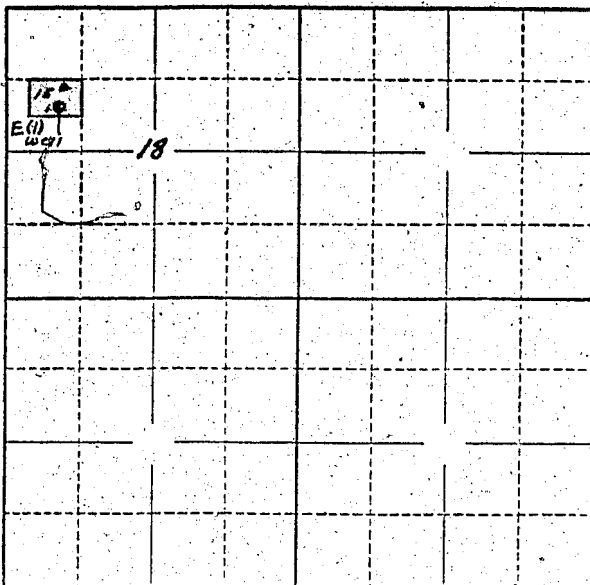

Locate well and acreage of irrigated land on plat.  
Scale: 2" = 1 Mile

STATE OF OREGON

County of Marion

I, Rudolph Zistel, being first duly sworn, do hereby certify that I have read the foregoing Registration Statement and that all of the items therein contained are true to the best of my knowledge and belief.

Rudolph Zistel  
(Signature of Registrant)

Subscribed and sworn to before me this 30<sup>th</sup> day of December, 1957.

My commission expires Sept. 8, 1960

Chas. H. Hulse  
(Notary Public)

(SEAL)

CERTIFICATE OF REGISTRATION

STATE OF OREGON

County of Marion } ss.

This is to certify that the foregoing Registration Statement was received in the office of the State Engineer on the 30 day of December, 1957, at 11:30 o'clock A. M. and has been duly recorded in said office in Book No. 5 of Registration Statements on page 813

Witness my hand this 21 day of February, 1958

Lewis A. Stanley  
(State Engineer)

By \_\_\_\_\_  
(Deputy)