

REGISTRATION NO. GR 815

CERTIFICATE NO. GR 815

Registration Statement

OF CLAIMANT OF RIGHT TO APPROPRIATE GROUND WATER

(Under Chapter 708, Oregon Laws 1955.)

TO THE STATE ENGINEER OF OREGON:

I, RAYMOND W. SMITH

of RT. 3 Junction City County of Lane

State of Oregon, do hereby make application for a certificate of registration as evidence of a right to appropriate ground water.

1. Source from which water is withdrawn is pump well #1
(Flowing well, pump well, infiltration trench, or tunnel)

2. Location is: 5 miles north of Junction City, Oregon
(Approximate distance and direction from nearest city or town)

and is more particularly described as follows:

(a) 144 S. & 300 W. of S.W. corner of NE 1/4 of NE 1/4 of Sec. 7, T. 15 S. R. 1 W
(Give distance and bearing to corner of section or other legal subdivision)

being within SW 1/4 of the NE 1/4 of Sec. 7, Twp. 15 S, Rge. 1 W
(Smallest legal subdivision) (N. or S.) (E. or W.)

or (b) within limits of recorded platted property, town or city:

in Lot _____, Block _____ of _____
(Name of plat or addition)

County of _____
(If within city or town, give name)

3. Construction Work was begun on 6-15-52; was completed on 6-18-52
(Date) (Date)

and the ground water claimed was first used for the purposes set out below on 6-23-52
(Date)

since which time the water has been used continuously
(Continuously or Intermittently)

from 6-23-52 to present
(Date) (Date)

4. Quantity of water claimed and used is 370 ⁸³⁰ gallons per minute; 75.75 acre feet per year.

5. Purpose or Purposes for which water is used irrigation

(Domestic, irrigation, municipal, manufacturing, industrial, etc.)

6. Description of Well: Depth 20 feet. Type 3 driven pipes in a 3' triangle
(Dug or drilled)

diameter all 3 inches. Elevation of ground at well site 340 feet, mean sea level.
(As near as known)

Depth to water table 12 feet.

7. Capacity of Well: 400 g.p.m. with 4 feet drawdown.

_____ g.p.m. with _____ feet drawdown.

Date of test July 1952

If Flowing Well: Measured discharge _____ g.p.m. on _____
(Date)

Shut-in pressure at ground surface _____ lbs. per sq. in. on _____
(Date)

Water is controlled by _____
(Cap, valve, etc.)

8. Casing: (Give diameter, commercial specifications and depth below ground surface of each casing size.)

3 inch diameter from surface to 20 feet
 inch diameter from to feet
 inch diameter from to feet
 inch diameter from to feet

Describe and show depth of shoe, plug, adapter, liner or other details:

9. Perforated Casings or Screens:

unk from to
 (Number per foot and size of perforations, or describe screen)
 from to
 from to
 from to

10. Log of Well: (Describe each stratum or formation clearly, indicate if water bearing, and give thickness and depth as indicated.)

MATERIAL	Thickness (Feet)	Depth to Bottom (Feet)
<i>unk</i>		✓

If log of well is not available, give name and address of driller.

11. Infiltration Trench: Covered or open
 Dimensions: Length Minimum depth ft. Maximum depth ft.
 Bottom width ft. Discharge g.p.m., Date of test

12. Tunnel: Type of lining
 Dimensions:
(Length, course, and cross sectional size)
 Position of water bearing stratum with reference to portal of tunnel

Log of tunnel: (Preceding table for log of well may be used, if desired. Give footage from portal and character of materials, as pertinent.)


13. Pumping Equipment:
 (a) Pump F.M. & Co. Centrifugal 3" Capacity 450 g.p.m.
(Make, type and size)
 (b) Motor 20 HP Electric
(Type and horsepower)

14. Location of area irrigated or to be irrigated, or place of use if for purposes other than irrigation.

Township North or South	Range E. or W. of Willamette Meridian	Section	Forty-acre Tract	Number Acres To Be Irrigated	Date of Reclamation
15 S	11W	7	NW 1/4 S1/4	0.6	6-23-52
"	"	"	SW 1/4 NE 1/4	20.63	"
"	"	"	NW 1/4 NE 1/4	9.07	"
				30.3 Total	

15. If the ground water supply is supplemental to an existing water supply, identification of any application for a permit, permit, certificate or adjudicated right to appropriate water made or held by the registrant.

Township 15 S Range 4 W, W.M.
North

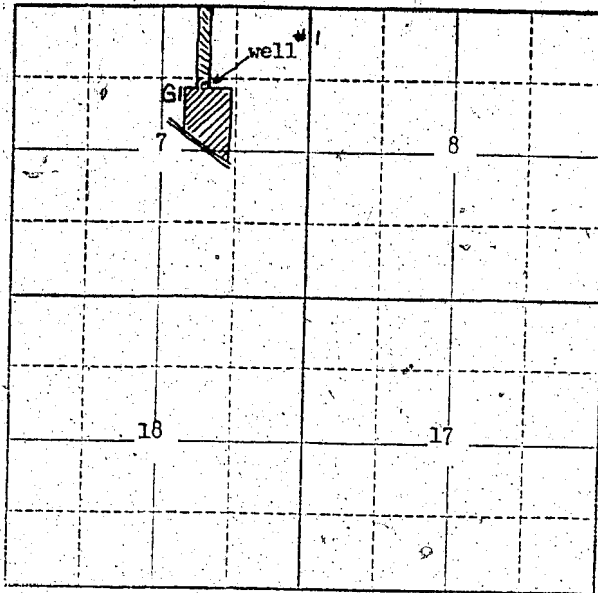

Locate well and acreage of irrigated land on plat.

Scale: 2" = 1 Mile

STATE OF OREGON

County of Linn

} ss.

I, Raymond W. Smith, being first duly sworn, do hereby certify that I have read the foregoing Registration Statement and that all of the items therein contained are true to the best of my knowledge and belief.

Raymond W. Smith
(Signature of Registrant)

Subscribed and sworn to before me this 21st day of November, 1957

My commission expires Aug. 10, 1959

Ray Zeller
(Notary Public)

(SEAL)

CERTIFICATE OF REGISTRATION

STATE OF OREGON

County of Marion

} ss.

This is to certify that the foregoing Registration Statement was received in the office of the State Engineer on the 30 day of December, 1957, at 8:00 o'clock A. M. and has been duly recorded in said office in Book No. 2 of Registration Statements on page 15

~~Construction shall be completed by XXXXXX and the water completely applied to beneficial use by XXXXXXXXXXXXXXXXXXXX~~

Witness my hand this 21 day of February, 1958

Laura A. Stanley
(State Engineer)

By _____ (Deputy)

GR-815 C

#154