

Registration Statement

OF CLAIMANT OF RIGHT TO APPROPRIATE GROUND WATER

TO THE STATE ENGINEER OF OREGON:

I, RAYMOND W. SMITH

of RT. 3 Junction City County of Lane

State of Oregon, do hereby make application for a certificate of registration as evidence of a right to appropriate ground water.

1. Source from which water is withdrawn is Pump well #2
(Flowing well, pump well, infiltration trench, or tunnel)

2. Location is: 2 1/2 miles North of Junction City, Oregon
(Approximate distance and direction from nearest city or town)

and is more particularly described as follows:

(a) 1170' E. and 720' N. of the Northeast corner of the John D. Hornbuckle D.L.C.
(Give distance and bearing to corner of section or other legal subdivision)
being within SW 1/4 SE 1/4 of Sec. 17, Twp. 15 S, Rge. 11 W
(Smallest legal subdivision) (N. or S.) (E. or W.)

or (b) within limits of recorded platted property, town or city:
in Lot _____, Block _____ of _____
(Name of plat or addition)

County of Lane
(If within city or town, give name)

3. Construction Work was begun on 6-20-52; was completed on 6-21-52
(Date) (Date)

and the ground water claimed was first used for the purposes set out below on 7-1-52
(Date)

since which time the water has been used continuously
(Continuously or Intermittently)

from 7-1-52 to present
(Date) (Date)

4. Quantity of water claimed and used is 190 gallons per minute; 60 acre feet per year.

5. Purpose or Purposes for which water is used irrigation

(Domestic, irrigation, municipal, manufacturing, industrial, etc.)

6. Description of Well: Depth 20 feet. Type driven
(Dug or drilled)

diameter 2 inches. Elevation of ground at well site 340 feet, mean sea level.
(As near as known)

Depth to water table 12 feet.

7. Capacity of Well: _____ g.p.m. with _____ feet drawdown.

_____ g.p.m. with _____ feet drawdown.


Date of test _____

If Flowing Well: Measured discharge _____ g.p.m. on _____
(Date)

Shut-in pressure at ground surface _____ lbs. per sq. in. on _____
(Date)

Water is controlled by _____
(Cap, valve, etc.)

Township 15 S Range 1 W W.M.
North

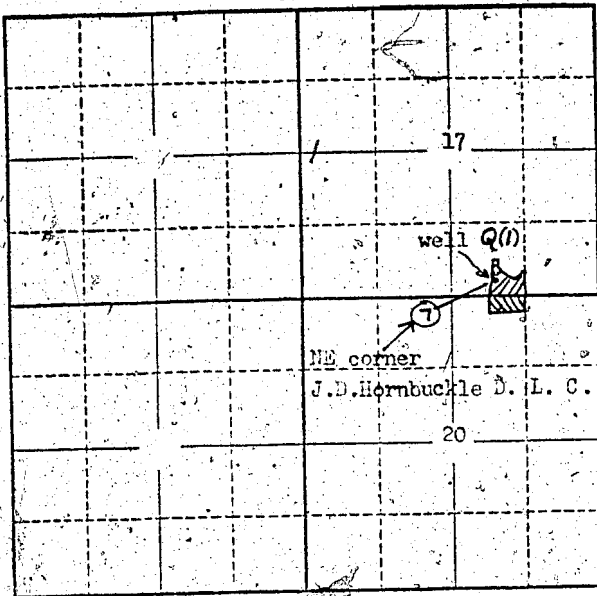

Locate well and acreage of irrigated land on plat.

Scale: 2" = 1 Mile

STATE OF OREGON

County of Lane FINN } ss.

I, Raymond W. Smith, being first duly sworn, do hereby certify that I have read the foregoing Registration Statement and that all of the items therein contained are true to the best of my knowledge and belief.

Raymond W. Smith
(Signature of Registrant)

Subscribed and sworn to before me this 21st day of November, 1957

My commission expires Aug 10, 1959

Ray Zell
(Notary Public)

(SEAL)

CERTIFICATE OF REGISTRATION

STATE OF OREGON

County of Marion } ss.

This is to certify that the foregoing Registration Statement was received in the office of the State Engineer on the 30 day of December, 1957, at 8:00 o'clock PM, and has been duly recorded in said office in Book No. 5 of Registration Statements on page 816

Witness my hand this 21 day of February, 1958

Lewis A. Stanley
(State Engineer)

By _____
(Deputy)