

RECEIVED  
STATE ENGINEER  
SALES DIVISION

# Registration Statement

REGISTRATION NO. GR-820  
CERTIFICATE NO. GR-820

## OF CLAIMANT OF RIGHT TO APPROPRIATE GROUND WATER (Under Chapter 708, Oregon Laws 1955.)

TO THE STATE ENGINEER OF OREGON:

I, Harvey Freitag

of 1014 E. 2nd, Albany County of Linn

State of Oregon do hereby make application for a certificate of registration as evidence of a right to appropriate ground water.

1. Source from which water is withdrawn is Pump well No. 1  
(Flowing well, pump well, infiltration trench, or tunnel)

2. Location is: 9 miles NE of Albany, Oregon  
(Approximate distance and direction from nearest city or town)

and is more particularly described as follows:

(a) S. 24° 10' E, 11.5 chains from NE corner of DIC 42, T. 10 S., R. 2W.  
(Give distance and bearing to corner of section or other legal subdivision)

being within NE 1/4 of SE 1/4 of Sec. 30, Twp 10 S, Rge. 2 W  
(Smallest legal subdivision) (N. or S.) (E. or W.)

or (b) within limits of recorded platted property, town or city:

in Lot \_\_\_\_\_, Block \_\_\_\_\_ of \_\_\_\_\_  
(Name of plat or addition)  
County of Linn  
(If within city or town, give name)

3. Construction Work was begun on May 1951; was completed on May 1951  
(Date) (Date)

and the ground water claimed was first used for the purposes set out below on June 1951  
(Date)

since which time the water has been used continuously  
(Continuously or intermittently)

from June 1951 to present time  
(Date) (Date)

4. Quantity of water claimed and used is 200 gallons per minute; 50.0 acre feet-per year.

5. Purpose or Purposes for which water is used Irrigation  
(Domestic, irrigation, municipal, manufacturing, industrial, etc.)

6. Description of Well: Depth 19 feet. Type Driven  
(Dug or drilled)

diameter 4 inches. Elevation of ground at well site 245 feet, mean sea level.  
(As near as known)

Depth to water table 8 feet.

7. Capacity of Well: 400 g.p.m. with 3 feet drawdown.  
\_\_\_\_\_ g.p.m. with \_\_\_\_\_ feet drawdown.

Date of test Estimated - not tested

If Flowing Well: Measured discharge \_\_\_\_\_ g.p.m. on \_\_\_\_\_ (Date)

Shut-in pressure at ground surface \_\_\_\_\_ lbs. per sq. in. on \_\_\_\_\_ (Date)

Water is controlled by \_\_\_\_\_  
(Cap, valve, etc.)

8. **Casing:** (Give diameter, commercial specifications and depth below ground surface of each casing size.)

4 inch diameter **steel casing** from 0 to 19 feet  
inch diameter from to feet  
inch diameter from to feet  
inch diameter from to feet

Describe and show depth of shoe, plug, adapter, liner or other details:

9. **Perforated Casings or Screens:**

Slot perforations from 16 to 19  
(Number per foot and size of perforations, or describe screen)  
from to  
from to  
from to

10. **Log of Well:** (Describe each stratum or formation clearly, indicate if water bearing, and give thickness and depth as indicated.)

MATERIAL	Thickness (Feet)	Depth to Bottom (Feet)
Not available		

If log of well is not available, give name and address of driller. Harvey Freitag

1014 E. 2nd St., Albany, Oregon

11. Infiltration Trench: Covered or open .....

Dimensions: Length ..... ft. Minimum depth ..... ft. Maximum depth ..... ft.

Bottom width ..... ft. Discharge ..... g.p.m. Date of test .....

12. Tunnel: Type of lining .....

Dimensions: .....  
(Length, course, and cross sectional size)

Position of water bearing stratum with reference to portal of tunnel .....

Log of tunnel: (Preceding table for log of well may be used, if desired. Give footage from portal and character of materials, as pertinent.)

13. Pumping Equipment:

(a) Pump Allis Chalmers 2 1/2" centrifugal Capacity 250 g.p.m.  
(Make, type and size)


(b) Motor 10 H. P. electric  
(Type and horsepower)

14. Location of area irrigated or to be irrigated, or place of use if for purposes other than irrigation.

Township North or South	Range E. or W. of Willamette Meridian	Section	Forty-acre Tract	Number Acres To Be Irrigated	Date of Reclamation
10 S	2 W	29	NW 1/4 of SW 1/4	3.5	June 1951
10 S	2 W	30	NE 1/4 of SE 1/4	16.5	
				20	

15. If the ground water supply is supplemental to an existing water supply, identification of any application for a perrait, permit, certificate or adjudicated right to appropriate water made or held by the registrant.

Township 10 S Range 2 W W.M. North

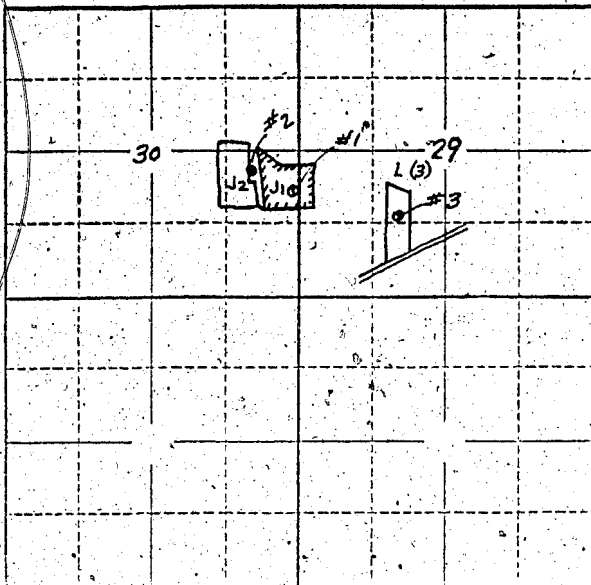

Locate well and acreage of irrigated land on plat. Scale: 2" = 1 Mile

STATE OF OREGON

County of Linn } SS.

I, Harvey Freitag, being first duly sworn, do hereby certify that I have read the foregoing Registration Statement and that all of the items therein contained are true to the best of my knowledge and belief.

Harvey Freitag  
(Signature of Registrant)

Subscribed and sworn to before me this 27<sup>th</sup> day of December, 1957

My commission expires May 11, 1960  
Raymond S. Strachan  
(Notary Public for Oregon)

(SEAL)

CERTIFICATE OF REGISTRATION

STATE OF OREGON

County of Marion } SS.

This is to certify that the foregoing Registration Statement was received in the office of the State Engineer on the 3<sup>rd</sup> day of January, 1958, at 8:00 o'clock A. M. and has been duly recorded in said office in Book No. 2 of Registration Statements on page 820.

~~Construction shall be completed by xxxxxxxxxxxxxxxx 19 xxx and the water completely applied in beneficial use by xxxxxxxxxxxxxxxx 19 xxx~~

Witness my hand this 21 day of February, 1958  
Lewis A. Stanley  
(State Engineer)

\$15.00

By \_\_\_\_\_ (Deputy)

GR-820 C