

# Registration Statement

## OF CLAIMANT OF RIGHT TO APPROPRIATE GROUND WATER

(Under Chapter 708, Oregon Laws 1955.)

TO THE STATE ENGINEER OF OREGON:

I, Albert E. Cole  
of Jefferson County of Marion

State of Oregon, do hereby make application for a certificate of registration as evidence of a right to appropriate ground water.

1. Source from which water is withdrawn is Pump Well  
(Flowing well, pump well, infiltration trench, or tunnel)

2. Location is: 6 mi N.W. off Jefferson Ave  
(Approximate distance and direction from nearest city or town)

and is more particularly described as follows:

(a) S. 60° E 910' N from W 1/4 cor. as projected within  
(Give distance and bearing to corner of section or other legal subdivision)

being within Reason Rely D.C. 48 of Sec. 29, Twp. 9 S, Rge. 3 W  
(Smallest legal subdivision) (N. or S.) (E. or W.)

or (b) within limits of recorded platted property, town or city:

in Lot \_\_\_\_\_, Block \_\_\_\_\_ of \_\_\_\_\_  
(Name of plat or addition)

County of \_\_\_\_\_  
(If within city or town, give name)

3. Construction Work was begun on 3-11-53; was completed on 3-12-53  
(Date) (Date)

and the ground water claimed was first used for the purposes set out below on 5-15-53  
(Date)

since which time the water has been used Intermittently  
(Continuously or Intermittently)

from 5-15-53 to 5-1-56  
(Date) (Date)

4. Quantity of water claimed and used is 214 gallons per minute; 276 acre feet per year.

5. Purpose or Purposes for which water is used Irrigation  
(Domestic, irrigation, municipal, manufacturing, industrial, etc.)

6. Description of Well: Depth 25 feet. Type Drilled  
(Dug or drilled)

diameter \_\_\_\_\_ inches. Elevation of ground at well site 190 feet, mean sea level.  
(As near as known)

Depth to water table 15 feet.

7. Capacity of Well: 500 g.p.m. with 5' feet drawdown.

\_\_\_\_\_ g.p.m. with \_\_\_\_\_ feet drawdown.

Date of test 2-15-53

If Flowing Well: Measured discharge \_\_\_\_\_ g.p.m. on \_\_\_\_\_  
(Date)

Shut-in pressure at ground surface \_\_\_\_\_ lbs. per sq. in. on \_\_\_\_\_  
(Date)

Water is controlled by \_\_\_\_\_  
(Cap, valve, etc.)

8. Casing: (Give diameter, commercial specifications and depth below ground surface of each casing size.)

8 inch diameter *Steel* from *0* to *25'* feet  
 inch diameter from to feet  
 inch diameter from to feet  
 inch diameter from to feet

Describe and show depth of shoe, plug, adapter, liner or other details:

9. Perforated Casings or Screens:

*Torch cut (3 x 1/2") perforations* from *19' 4"* to *25' 4"*  
(Number per foot and size of perforations, or describe screen)  
 from to  
 from to  
 from to

10. Log of Well: (Describe each stratum or formation clearly, indicate if water bearing, and give thickness and depth as indicated.) *No log available*

MATERIAL	Thickness (Feet)	Depth to Bottom (Feet)
<i>Approx. 0' - 12' River Silt</i>	<i>12'</i>	<i>13'</i>
<i>" 12 - 25 River Gravels</i>	<i>13'</i>	<i>to bottom</i>

If log of well is not available, give name and address of driller. *Bill Hamilton*  
*Albany, Oregon*

11. Infiltration Trench: Covered or open \_\_\_\_\_  
 Dimensions: Length \_\_\_\_\_ ft. Minimum depth \_\_\_\_\_ ft. Maximum depth \_\_\_\_\_ ft.  
 Bottom width \_\_\_\_\_ ft. Discharge \_\_\_\_\_ g.p.m. Date of test \_\_\_\_\_

12. Tunnel: Type of lining \_\_\_\_\_  
 Dimensions: \_\_\_\_\_  
(Length, course, and cross sectional size)  
 Position of water bearing stratum with reference to portal of tunnel \_\_\_\_\_

Log of tunnel: (Preceding table for log of well may be used, if desired. Give footage from portal and character of materials, as pertinent.)


13. Pumping Equipment:  
 (a) Pump *Fairbanks Morse 4" in x 5554 dia* Capacity *580* g.p.m.  
(Make, type and size)  
 (b) Motor *Fairbanks Morse 20 HP* *3 phase Elect*  
(Type and horsepower)

14. Location of area irrigated or to be irrigated, or place of use if for purposes other than irrigation:

Township North or South	Range E. or W. of Willamette Meridian	Section	Forty-acre Tract	Number Acres To Be Irrigated	Date of Reclamation
9 S	5 W	29	SW NW	10	15 Apr 53
			SE NW	10	15 Apr 53
			NE SW	120	15 Apr 53
			NW SW	150	15 Apr 53
			SW SW	10	15 Apr 53
				300	

15. If the ground water supply is supplemental to an existing water supply, identification of any application for a permit, permit, certificate or adjudicated right to appropriate water made or held by the registrant.

Township 9 S Range 3 W, W.M.  
North

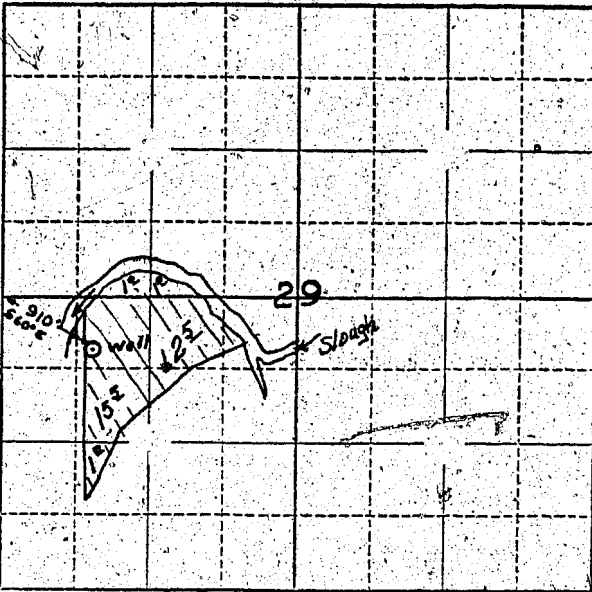

Locate well and acreage of irrigated land on plat.  
Scale: " — 1 Mile

STATE OF OREGON

County of Marion } ss.

I, Albert E. Cole, being first duly sworn, do hereby certify that I have read the foregoing Registration Statement and that all of the items therein contained are true to the best of my knowledge and belief.

Albert E. Cole  
(Signature of Registrant)

Subscribed and sworn to before me this 20 day of January, 1956.

My commission expires 9/27/58

Jeanie Boster  
(Notary Public)

(SEAL)

### CERTIFICATE OF REGISTRATION

STATE OF OREGON

County of Marion } ss.

This is to certify that the foregoing Registration Statement was received in the office of the State Engineer on the 20th day of January, 1956, at 1:00 o'clock P.M. and has been duly recorded in said office in Book No. 1 of Registration Statements on page 72.

Construction shall be completed by 19, 1956, and the water completely applied to beneficial use by 19, 1956.

Witness my hand this 24th day of February, 1956.

Lewis H. Stanley  
(State Engineer)

By \_\_\_\_\_  
(Deputy)