

RECEIVED  
STATE ENGINEER  
OFFICE

REGISTRATION NO. 62-850

# Registration Statement

CERTIFICATE NO. OR-821

## OF CLAIMANT OF RIGHT TO APPROPRIATE GROUND WATER

(Under Chapter 708, Oregon Laws 1955.)

TO THE STATE ENGINEER OF OREGON:

I, Harvey Freitag

of 10th E. 2nd, Albany County of Linn

State of Oregon, do hereby make application for a certificate of registration as evidence of a right to appropriate ground water.

1. Source from which water is withdrawn is Pump Well No. 2  
(Flowing well, pump well, infiltration trench, or tunnel)

2. Location is: 9 miles NE of Albany, Oregon  
(Approximate distance and direction from nearest city or town)

and is more particularly described as follows:

(a) S. 66° 10' W., 11 chains from NE corner 42, T. 10 S, R. 2 W.  
(Give distance and bearing to corner of section or other legal subdivision)

being within \_\_\_\_\_ of Sec. \_\_\_\_\_, Twp. \_\_\_\_\_, Rge. \_\_\_\_\_  
(Smallest legal subdivision) (N. or S.) (E. or W.)

or (b) within limits of recorded platted property, town or city: \_\_\_\_\_

in Lot \_\_\_\_\_, Block \_\_\_\_\_ of \_\_\_\_\_  
(Name of plat or addition)

County of Linn  
(If within city or town, give name)

3. Construction Work was begun on May 1951; was completed on May 1951  
(Date) (Date)

and the ground water claimed was first used for the purposes set out below on June 1951  
(Date)

since which time the water has been used Intermittently  
(Continuously or Intermittently)

from June 1951 to present time  
(Date) (Date)

4. Quantity of water claimed and used is 130 gallons per minute; 23.25 acre feet per year.

5. Purpose or Purposes for which water is used Irrigation  
(Domestic, irrigation, municipal, manufacturing, industrial, etc.)

6. Description of Well: Depth 14 feet. Type Dug  
(Dug or drilled)  
diameter 4 inches. Elevation of ground at well site 245 feet, mean sea level.  
(As near as known)

Depth to water table 8 feet.

7. Capacity of Well: 130 g.p.m. with 4 feet drawdown.  
\_\_\_\_\_ g.p.m. with \_\_\_\_\_ feet drawdown.

Date of test Estimated - not tested

If Flowing Well: Measured discharge \_\_\_\_\_ g.p.m. on \_\_\_\_\_  
(Date)


Shut-in pressure at ground surface \_\_\_\_\_ lbs. per sq. in. on \_\_\_\_\_  
(Date)

Water is controlled by \_\_\_\_\_  
(Cap. valve, etc.)





Township 10 S Range 2 W W.M.  
North

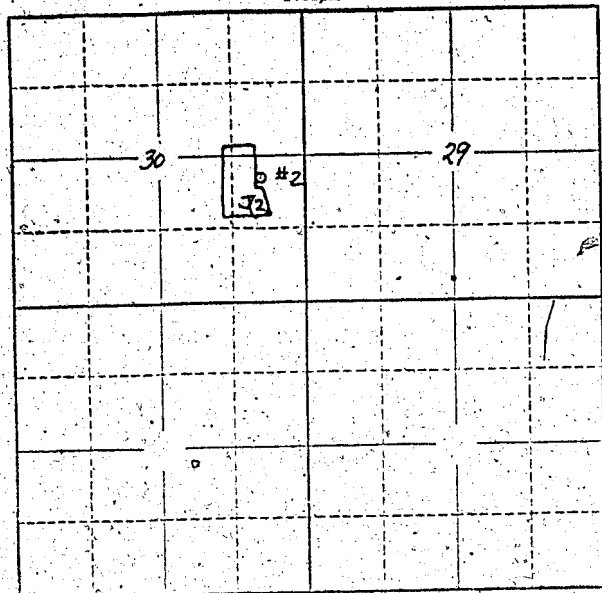

Locate well and acreage of irrigated land on plat.  
Scale: 2" = 1 Mile.

STATE OF OREGON }  
County of LINN } ss.

I, Harvey Freitag, being first duly sworn, do hereby certify that I have read the foregoing Registration Statement and that all of the items therein contained are true to the best of my knowledge and belief.

*Harvey Freitag*  
(Signature of Registrant)

Subscribed and sworn to before me this 27<sup>th</sup> day of December, 1957

My commission expires May 11, 1960 *Raymond S. Mackintosh*  
(Notary Public for Oregon)

(SEAL)

CERTIFICATE OF REGISTRATION

STATE OF OREGON }  
County of Marion } ss.

This is to certify that the foregoing Registration Statement was received in the office of the State Engineer on the 3<sup>rd</sup> day of January, 1958, at 6:00 o'clock P.M. and has been duly recorded in said office in Book No. 5 of Registration Statements on page 821

~~Construction shall be completed by xxxxxxxxxxxxxxxxxxxxxxxx 1958, and the water completely applied to beneficial use by xxxxxxxxxxxxxxxxxxxxxxxx 1958.~~

Witness my hand this 21 day of February, 1958

*Leora A. Stanley*  
(State Engineer)

15.00

By \_\_\_\_\_ (Deputy)

GR-821 C