

RECEIVED  
SALES TAX  
SALES TAX

# Registration Statement

REGISTRATION NO. 62852

CERTIFICATE NO. 62-822

## OF CLAIMANT OF RIGHT TO APPROPRIATE GROUND WATER

(Under Chapter 708, Oregon Laws 1955.)

TO THE STATE ENGINEER OF OREGON:

I, Harvey Freitag

of 10th E. 2nd, Albany County of Linn

State of Oregon do hereby make application for a certificate of registration as evidence of a right to appropriate ground water.

1. Source from which water is withdrawn is Pump well No. 3

(Flowing well, pump well, infiltration trench, or tunnel)

2. Location is: 9 miles NE of Albany, Oregon

(Approximate distance and direction from nearest city or town)

and is more particularly described as follows:

(a) S. 61° 45' E. 37.5 chains from NE $\frac{1}{4}$  of DLC 42; T. 10 S., R. 2 W.

(Give distance and bearing to corner of section or other legal subdivision)

being within NE $\frac{1}{4}$  of SW $\frac{1}{4}$  of Sec. 29, Twp. 10 S., Rge. 2 W.

(Smallest legal subdivision)

(N. or S.)

(E. or W.)

or (b) within limits of recorded platted property, town or city:

in Lot \_\_\_\_\_, Block \_\_\_\_\_ of \_\_\_\_\_

(Name of plat or addition)

County of Linn

(If within city or town, give name)

3. Construction Work was begun on May 1949; was completed on May 1949

(Date)

(Date)

and the ground water claimed was first used for the purposes set out below on June 1949

(Date)

since which time the water has been used Intermittently

(Continuously or Intermittently)

from June 1949 to present time

(Date)

(Date)

4. Quantity of water claimed and used is 250 gallons per minute; 30.75 acre feet per year.

5. Purpose or Purposes for which water is used Irrigation

(Domestic, irrigation, municipal, manufacturing, industrial, etc.)

6. Description of Well: Depth 20 feet. Type Driven

(Dug or drilled)

diameter 5 $\frac{1}{2}$  inches. Elevation of ground at well site 245 feet, mean sea level.

(As near as known)

Depth to water table 8 feet.

7. Capacity of Well: 300 g.p.m. with 5 feet drawdown.

\_\_\_\_\_ g.p.m. with \_\_\_\_\_ feet drawdown.

Date of test Estimated - not tested

If Flowing Well: Measured discharge \_\_\_\_\_ g.p.m. on \_\_\_\_\_

(Date)

Shut-in pressure at ground surface \_\_\_\_\_ lbs. per sq. in. on \_\_\_\_\_

(Date)

Water is controlled by \_\_\_\_\_

(Cap. valve, etc.)

8. Casing: (Give diameter, commercial specifications and depth below ground surface of each casing size.)

3 1/2 inch diameter **steel casing** from 0 to 20 feet  
 inch diameter from to feet  
 inch diameter from to feet  
 inch diameter from to feet

Describe and show depth of shoe, plug, adapter, liner or other details

9. Perforated Casings or Screens:

Slot perforations from 17 to 20  
(Number per foot and size of perforations, or describe screen)  
 from to  
 from to  
 from to

10. Log of Well: (Describe each stratum or formation clearly, indicate if water bearing, and give thickness and depth as indicated.)

MATERIAL	Thickness (Feet)	Depth to Bottom (Feet)
Not available		

If log of well is not available, give name and address of driller. Harvey Freitag, 1014 E. 2nd, Albany,  
Oregon

11. Infiltration Trench: Covered or open \_\_\_\_\_  
 Dimensions: Length \_\_\_\_\_ ft. Minimum depth \_\_\_\_\_ ft. Maximum depth \_\_\_\_\_ ft.  
 Bottom width \_\_\_\_\_ ft. Discharge \_\_\_\_\_ g.p.m. Date of test \_\_\_\_\_
12. Tunnel: Type of lining \_\_\_\_\_  
 Dimensions: \_\_\_\_\_  
(Length, course, and cross sectional size)  
 Position of water bearing stratum with reference to portal of tunnel \_\_\_\_\_

Log of tunnel: (Preceding table for log of well may be used, if desired. Give footage from portal and character of materials, as pertinent.)

13. Pumping Equipment:


- (a) Pump 2" centrifugal \_\_\_\_\_ Capacity 250 g.p.m.  
(Make, type and size)
- (b) Motor Tractor \_\_\_\_\_  
(Type and horsepower)

14. Location of area irrigated or to be irrigated, or place of use if for purposes other than irrigation.

Township North or South	Range E. or W. of Willamette Meridian	Section	Forty-acre Tract	Number Acres To Be Irrigated	Date of Reclamation
10 S	2 W	29	NE $\frac{1}{4}$ of SW $\frac{1}{4}$	6.5	June 1949
10 S	2 W	29	SE $\frac{1}{4}$ of SW $\frac{1}{4}$	5.8	" "
				12.3	

15. If the ground water supply is supplemental to an existing water supply, identification of any application for a permit, permit, certificate or adjudicated right to appropriate water made or held by the registrant.

Township 10 S Range 2 W / , W.M.  
North

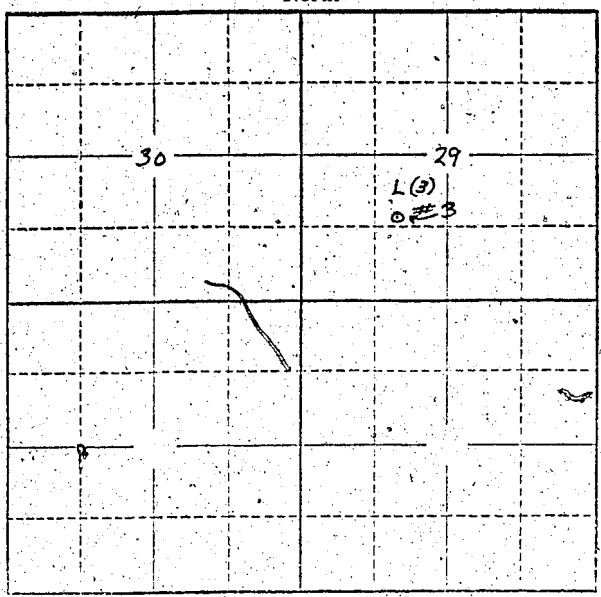

Locate well and acreage of irrigated land on plat.  
Scale: 2" = 1 Mile

STATE OF OREGON }  
County of Linn } ss.

I, Harvey Freitag, being first duly sworn, do hereby certify that I have read the foregoing Registration Statement and that all of the items therein contained are true to the best of my knowledge and belief.

Harvey Freitag  
(Signature of Registrant)

Subscribed and sworn to before me this 27<sup>th</sup> day of December, 1957

My commission expires May 11, 1960

Raymond S. Perkins  
(Notary Public)

(SEAL)

**CERTIFICATE OF REGISTRATION**

STATE OF OREGON }  
County of Marion } ss.

This is to certify that the foregoing Registration Statement was received in the office of the State Engineer on the 3<sup>rd</sup> day of January, 1958, at 11 o'clock A.M. and has been duly recorded in said office in Book No. 5 of Registration Statements on page 822

~~Construction shall be completed by xxxxxxxxxxxxxxxx 1958 and the water completely applied xxxxxxxxxxxxxxxx for beneficial use by xxxxxxxxxxxxxxxx 1958~~

Witness my hand this 21 day of February, 1958

Lewis A. Stanley  
(State Engineer)

By \_\_\_\_\_  
(Deputy)

GR-822 C

#1520