

RECEIVED
STATE ENGINEER
CORVALLIS, OREGON

Registration No. GR-854
Certificate No. GR-827

Registration Statement

OF CLAIMANT OF RIGHT TO APPROPRIATE GROUND WATER

TO THE STATE ENGINEER OF OREGON:

I, Fred C. and Dora E. Myers
of 1110 N. 33rd St., Corvallis County of Linn
(Mailing address)
State of Oregon, do hereby make application for a certificate of registration as evidence of a right to appropriate ground water.

- 1. Source from which water is withdrawn is lump well
(Flowing well, pump well, infiltration trench, or tunnel)
- 2. Location is: 1 1/2 miles southeast of Corvallis, Oregon
(Approximate distance and direction from nearest city or town)

and is more particularly described as follows:

(a) S. 21° 30' E. 1600 ft. from NW corner S. 5, T. 12 S, R. 1 W.
(Give distance and bearing to corner of section or other legal subdivision)

being within S. 1/4 of NW 1 of Sec. 6, Twp. 12, Rge. 1
(Smallest legal subdivision) (N. or S.) (E. or W.)

or (b) within limits of recorded platted property, town or city:
in Lot _____, Block _____ of _____
(Name of plat or addition)

County of Linn
(If within city or town, give name)

3. Construction Work was begun on June 1951; was completed on June 1951
(Date) (Date)

and the ground water claimed was first used for the purposes set out below on June 1951
(Date)

since which time the water has been used continuously
(Continuously or intermittently)

from June 1951 to present time
(Date) (Date)

4. Quantity of water claimed and used is 150 gallons per minute; 37.5 acre feet per year.

5. Purpose or Purposes for which water is used Irrigation
(Domestic, irrigation, municipal, manufacturing, industrial, etc.)

6. Description of Well: Depth 34 feet. Type lump
(Dug or drilled)

diameter 6 inches. Elevation of ground at well site _____ feet, mean sea level.
(As near as known)

Depth to water table _____ feet.

7. Capacity of Well: _____ g.p.m. with _____ feet drawdown.

_____ g.p.m. with _____ feet drawdown.

Date of test estimated - not tested

If Flowing Well: Measured discharge _____ g.p.m. on _____
(Date)

Shut-in pressure at ground surface _____ lbs. per sq. in. on _____
(Date)

Water is controlled by _____
(Cap, valve, etc.)

If log of well is not available, give name and address of driller. Gilbert Pruett, Rt. 4, Corvallis, Oregon

11. Infiltration Trench: Covered or open

Dimensions: Length ft. Minimum depth ft. Maximum depth ft.

Bottom width ft. Discharge g.p.m. Date of test

12. Tunnel: Type of lining

Dimensions:
(Length, course, and cross sectional size)

Position of water bearing stratum with reference to portal of tunnel

Log of tunnel: (Preceding table for log of well may be used, if desired. Give footage from portal and character of materials, as pertinent.)

13. Pumping Equipment:

(a) Pump Fairbanks Morse 2" centrifugal Capacity 200 g.p.m.
(Make, type and size)


(b) Motor 10 H.P. electric
(Type and horsepower)

14. Location of area irrigated or to be irrigated, or place of use if for purposes other than irrigation.

Township North or South	Range E. or W. of Willamette Meridian	Section	Forty-acre Tract	Number Acres To Be Irrigated	Date of Reclamation
12 S	4 W.	6	NE $\frac{1}{4}$ of NW $\frac{1}{4}$	0.6	June 1954
12 S	4 W.	6	NW $\frac{1}{4}$ of NW $\frac{1}{4}$	4.6	June 1954
12 S	4 W.	6	SW $\frac{1}{4}$ of NW $\frac{1}{4}$	9.2	June 1954
12 S	4 W.	6	SE $\frac{1}{4}$ of NW $\frac{1}{4}$	0.7	June 1954
				15.0	

15. If the ground water supply is supplemental to an existing water supply, identification of any application for a permit, permit, certificate or adjudicated right to appropriate water made or held by the registrant.

Township 12 S Range 1 W., W.M.
North

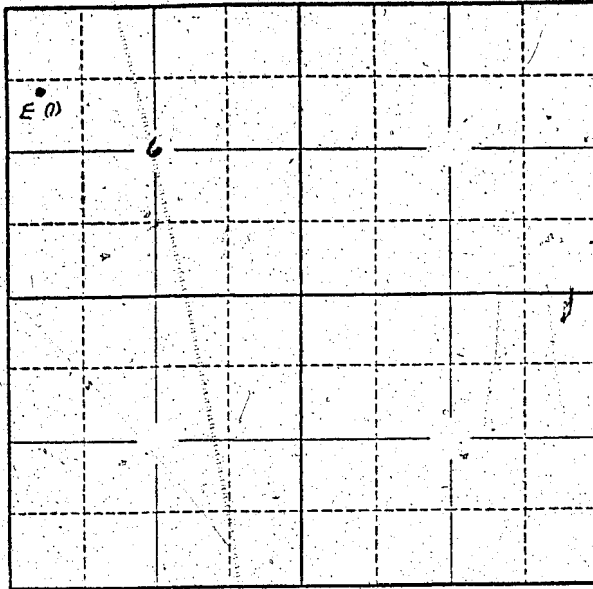

Locate well and acreage of irrigated land on plat.
Scale: 2" = 1 Mile

STATE OF OREGON }
County of Linn Beston } SS.

I, Fred C. and Dora E. Myers, being first duly sworn, do hereby certify that I have read the foregoing Registration Statement and that all of the items therein contained are true to the best of my knowledge and belief.

Fred C. Myers
(Signature of Registrant)

Subscribed and sworn to before me this 30 day of December, 1958

My commission expires 1959
Edward G. Gault
(Notary Public)

(SEAL)

CERTIFICATE OF REGISTRATION

STATE OF OREGON }
County of Marion } SS.

This is to certify that the foregoing Registration Statement was received in the office of the State Engineer on the 30 day of January, 1958, at 11:00 o'clock A.M. and has been duly recorded in said office in Book No. 5 of Registration Statements on page 827.

Witness my hand this 5 day of March, 1958.

Lewis A. Stanley
(State Engineer)

By _____
(Deputy)

GR. 827 C