

Registration Statement

OF CLAIMANT OF RIGHT TO APPROPRIATE GROUND WATER

(Under Chapter 708, Oregon Laws 1955.)

TO THE STATE ENGINEER OF OREGON:

State of Ore., do hereby make application for a certificate of registration as evidence
of a right to appropriate ground water.

1. Source from which water is withdrawn is Flowing well, pump well, infiltration trench, or tunnel

2. Location is: 2 miles East of Medford
(Approximate distance and direction from nearest city or town)

and is more particularly described as follows:

(a) NE 1/4 Sec. 21, Twp. 12N, Rge. 12E
(Give distance and bearing to corner of section or other legal subdivision)

being within NE 1/4 Sec. 21 of Sec. 21, Twp. 12N, Rge. 12E
(Smallest legal subdivision) (N. or S.) (E. or W.)

or (b) within limits of recorded platted property, town or city:

In Lot , Block of
(Name of plat or addition)

County of Medford
(If within city or town, give name)

3. Construction Work was begun on April 25, 1942, was completed on
(Date) (Date)

and the ground water claimed was first used for the purposes set out below on
(Date)

since which time the water has been used Continuously
(Continuously or intermittently)

from May 1942 to Oct 1957
(Date) (Date)

4. Quantity of water claimed and used is 190 gallons per minute; acre
feet per year.

5. Purpose or Purposes for which water is used

(Domestic, irrigation, municipal, manufacturing, industrial, etc.)

6. Description of Well: Depth feet, Type
(Dug or drilled)

diameter 5 inches; Elevation of ground at well site feet, mean sea level.
(As near as known)

Depth to water table 2 feet.

7. Capacity of Well: g.p.m. with 8 feet drawdown.

 g.p.m. with feet drawdown.

Date of test

If Flowing Well: Measured discharge g.p.m. on
(Date)

Shut-in pressure at ground surface lbs. per sq. in. on
(Date)

Water is controlled by
(Pump, valve, etc.)

3	inch diameter	steel casing	from 7	to 6	feet
	inch diameter		from	to	feet
	inch diameter		from	to	feet
	inch diameter		from	to	feet

None

Material	from	to
Mo open end (Number per foot and size of perforations) or describe screen		
	from	to
	from	to
	from	to
	from	to

[illegible]

GR- 323 A



11. Infiltration Trench: Covered or open

Dimensions: Length ft. Minimum depth ft. Maximum depth ft.

Bottom width ft. Discharge g.p.m. Date of test

12. Tunnel: Type of lining

Dimensions: _____ (Length, course, and cross sectional size)

Position of water bearing stratum with reference to portal of tunnel

Log of tunnel: (Preceding table for log of well may be used, if desired. Give footage from portal and character of materials, as pertinent.)

13. Pumping Equipment:

(a) Pump Jacuzzi Centrifugal Capacity 240 g.p.m.
(Make, type and size)

(b) Motor 5 HP Electric Motor
(Type and horsepower)


14. Location of area irrigated or to be irrigated, or place of use if for purposes other than irrigation.

[illegible]

15. If the ground water supply is supplemental to an existing water supply, identification of any application for a permit, permit, certificate, or adjudicated right to appropriate water made or held by the registrant.

GR-529 B

North

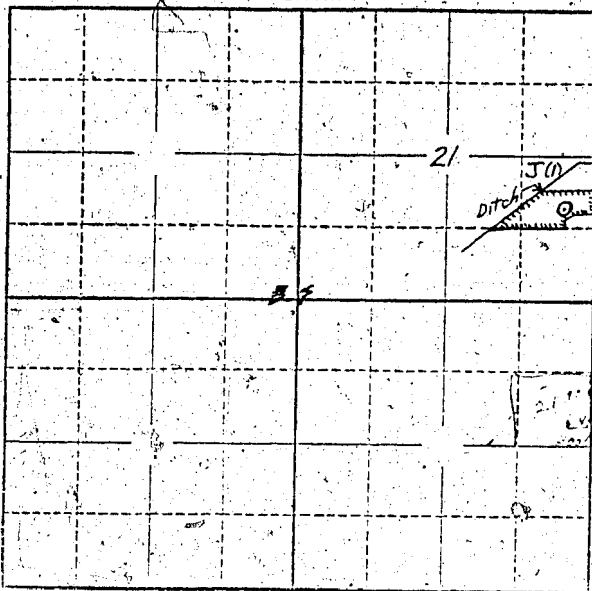

Scale: 2" = 1 Mile


SS

being first duly sworn, do hereby certify that I have
of the items therein contained are true to the best of

(Signature of Registrant

Subscribed and sworn to before me this 31 day of December 1977

My commission expires April 1, 1966

(Notary Public)

(SEAL)

CERTIFICATE OF REGISTRATION

County of Marion

SS.

This is to certify that the foregoing Registration Statement was received in the office of the State Engineer on the 3 day of January, 1958, at 2:00 o'clock P.M. and has been duly recorded in said office in Book No. 4 of Registration Statements on page 829

Construction shall be completed by _____ and the water completely applied for beneficial use by _____. 19_____

Witness my hand this 5 day of March 1958

(State Engineer)

Bv

(Deputy)

GR- 823 C