

Registration Statement

OF CLAIMANT OF RIGHT TO APPROPRIATE GROUND WATER

TO THE STATE ENGINEER OF OREGON:

I, VICTOR LANINI and MARIE M. LANINI

of Palms Coburg Ore. County of DeS

State of Oregon, do hereby make application for a certificate of registration as evidence of a right to appropriate ground water.

1. Source from which water is withdrawn is well
(Flowing well, pump well, infiltration trench, or tunnel)

2. Location is: North of ...
(Approximate distance and direction from nearest city or town)

and is more particularly described as follows:

(a) ...
(Give distance and bearing to corner of section or other legal subdivision)

being within ... of Sec. ... Twp. ... Rge. ...
(Smallest legal subdivision) (N. or S.) (E. or W.)

or (b) within limits of recorded platted property, town or city:

in Lot ..., Block ... of ...
(Name of plat or addition)

County of ...

(If within city or town, give name)

3. Construction Work was begun on April 1945, was completed on ...
(Date) (Date)

and the ground water claimed was first used for the purposes set out below on ...
(Date)

since which time the water has been used ...
(Continuously or intermittently)

from July 1945 to late
(Date) (Date)

4. Quantity of water claimed and used is ... gallons per minute; ... acre feet per year.

5. Purpose or Purposes for which water is used ...

(Domestic, irrigation, municipal, manufacturing, industrial, etc.)

6. Description of Well: Depth 15 feet. Type ...
(Dug or drilled)

diameter ... inches. Elevation of ground at well site 320' feet, mean sea level.
(As near as known)

Depth to water table 10' feet.

7. Capacity of Well: ... g.p.m. with ... feet drawdown.

... g.p.m. with ... feet drawdown.

Date of test ...


If Flowing Well: Measured discharge ... g.p.m. on ...
(Date)

Shut-in pressure at ground surface ... lbs. per sq. in. on ...
(Date)

Water is controlled by ...
(Cap, valve, etc.)

Township 76 S Range 3 W, W.M.

North

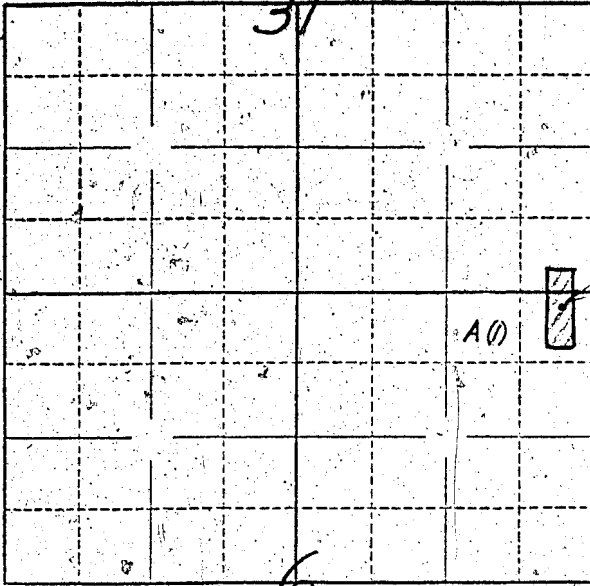

well
T16S R3W
T17S R3W

Locate well and acreage of irrigated land on plat.

Scale: 2" = 1 Mile

STATE OF OREGON

County of Marion } ss.

I, Victor Lanni, being first duly sworn, do hereby certify that I have read the foregoing Registration Statement and that all of the items therein contained are true to the best of my knowledge and belief.

Victor Lanni
(Signature of Registrant)

Subscribed and sworn to before me this 31st day of December, 1957

My commission expires 4/12/61 R. B. Brown
(Notary Public)

(SEAL)

CERTIFICATE OF REGISTRATION

STATE OF OREGON

County of Marion } ss.

This is to certify that the foregoing Registration Statement was received in the office of the State Engineer on the 6th day of January, 1958, at 8:00 o'clock A. M. and has been duly recorded in said office in Book No. 5 of Registration Statements on page 830

Witness my hand this 5 day of March, 1958.

Lewis A. Stanley
(State Engineer)

By _____
(Deputy)