

Registration Statement

OF CLAIMANT OF RIGHT TO APPROPRIATE GROUND WATER

(Under Chapter 708, Oregon Laws 1955.)

TO THE STATE ENGINEER OF OREGON:

I, Ray J. Glatt and Elizabeth J. Glatt

of Rt. 1, Woodburn County of Marion

State of Oregon do hereby make application for a certificate of registration as evidence of a right to appropriate ground water.

- 1. Source from which water is withdrawn is Deep Well
(Flowing well, pump well, infiltration trench, or tunnel)
- 2. Location is: 1/2 mile N. W. of Woodburn
(Approximate distance and direction from nearest city or town)

and is more particularly described as follows: thence S. 11° 24' W., 402' from cor. of secs. 6 & 7 T5S R1W and Secs. 1 and 12 T5S R2W of Will. Mer.

(a) being within NW 1/4 of NW 1/4 of Sec. 38 Twp. 38 Rge. 1W
(Smallest legal subdivision) (N. or S.) (E. or W.)

or (b) within limits of recorded platted property, town or city:

in Lot _____, Block _____ of _____
(Name of plat or addition)

County of Marion
(If within city or town, give name)

- 3. Construction Work was begun on Sept. 15, 1950 and was completed on Oct. 12, 1950
(Date)

and the ground water claimed was first used for the purposes set out below on June 1, 1951
(Date)

since which time the water has been used Continuously
(Continuously or Intermittently)

from June 1, 1951 to Jan. 1, 1958
(Date) (Date)

4. Quantity of water claimed and used is 600 gallons per minute; _____ acre feet per year.

- 5. Purpose or Purposes for which water is used Irrigation

6. Description of Well: Depth 120 feet. Type Bored (Gravel Packed)
(Domestic, irrigation, municipal, manufacturing, industrial, etc.) (Dug or drilled)

diameter 10 inches. Elevation of ground at well site 182 feet, mean sea level.
(As near as known)

Depth to water table 25 feet.

- 7. Capacity of Well: 700 g.p.m. with 50 feet drawdown.
- _____ g.p.m. with _____ feet drawdown.

Date of test Oct. 10, 1950

If Flowing Well: Measured discharge _____ g.p.m. on _____
(Date)

Shut-in pressure at ground surface _____ lbs. per sq. in. on _____
(Date)

Water is controlled by _____
(Cap. valve, etc.)

8. **Casing:** (Give diameter, commercial specifications and depth below ground surface of each casing size.)

10 ID inch diameter Galvanized from Top to 120 feet
 inch diameter from to feet
 inch diameter from to feet
 inch diameter from to feet

Describe and show depth of shoe, plug, adapter, liner or other details:

Half Coupling for Shoe (Welded)

9. **Perforated Casings or Screens:**

Perforated with Acet. Torch 3/8 by 6 from 100' to 120'
(Number per foot and size of perforations, or describe screen)

from to
 from to
 from to

10. **Log of Well:** (Describe each stratum or formation clearly, indicate if water bearing, and give thickness and depth as indicated.)

MATERIAL	Thickness (Feet)	Depth to Bottom (Feet)
Top Soil	3	3
Silty yellow clay	24	27
Blue Clay	73	100
Black Sand (Water)	18	118
Sand & Coarse Black Gravel (Water)	2	120
Blue Clay	?	?
This well was bored with 18" auger to 100' ft. then casing was run. (welded joints) Well was then gravel packed and surged down to 120 ft.		

If log of well is not available, give name and address of driller.

Roy Perkins Rt. 2, Box 315, Salem, Oregon

11. Infiltration Trench: Covered or open

Dimensions: Length ft. Minimum depth ft. Maximum depth ft.

Bottom width ft. Discharge g.p.m. Date of test

12. Tunnel: Type of lining

Dimensions: (Length, course, and cross sectional size)

Position of water bearing stratum with reference to portal of tunnel

Log of tunnel: (Preceding table for log of well may be used, if desired. Give footage from portal and character of materials, as pertinent.)

13. Pumping Equipment:

(a) Pump Peerless Lineshaft Turbine Capacity 600 g.p.m.
(Make, type and size)


(b) Motor 40 HP electric, vertical hollowshaft
(Type and horsepower)

14. Location of area irrigated or to be irrigated, or place of use if for purposes other than irrigation.

Township North or South	Range E. or W. of Willamette Meridian	Section	Forty-acre Tract	Number Acres To Be Irrigated	Date of Reclamation
5S	2W	1	SE 1/4 of SE 1/4	23.8	June 1, 1957
5S	2W	1	NE 1/4 of SE 1/4	1.7	" "
5S	2W	12	NE 1/4 of NE 1/4	1.4	" "
5S	1W	6	SW 1/4 of SW 1/4	39.2	" "
5S	1W	6	NW 1/4 of SW 1/4	7.6	" "
5S	1W	7	NW 1/4 of NW 1/4	14.2	" "
5S	1W	7	NE 1/4 of NW 1/4	36.3	" "
5S	1W	7	NW 1/4 of NE 1/4	20.0	" "
5S	1W	7	SW 1/4 of NE 1/4	4.8	" "
5S	1W	7	NE 1/4 of NE 1/4	21.7	" "
5S	1W	7	SE 1/4 of NE 1/4	6.6	" "
5S	1W	8	NW 1/4 of NW 1/4	10.9	" "
5S	1W	8	SW 1/4 of NW 1/4	2.9	" "
				191.1 Ac	

15. If the ground water supply is supplemental to an existing water supply, identification of any application for a permit, permit, certificate or adjudicated right to appropriate water made or held by the registrant.

Township 55 Range 1W, W.M.
North

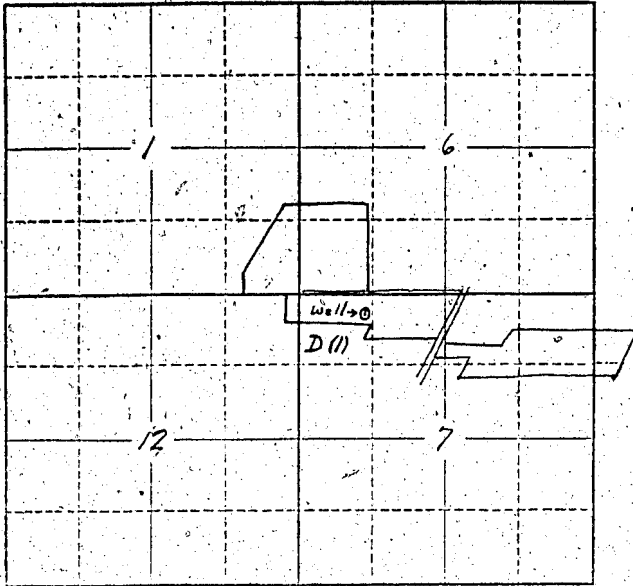

Locate well and acreage of irrigated land on plat.

Scale: 2" = 1 Mile

See Map Attached

STATE OF OREGON

County of Marion } ss.

I, _____, being first duly sworn, do hereby certify that I have read the foregoing Registration Statement and that all of the items therein contained are true to the best of my knowledge and belief.

Ray Elatt
(Signature of Registrant)

Subscribed and sworn to before me this 6th day of January, 1958.

My commission expires June 12th, 1961.
Wm. S. Bartholmes
(Notary Public)

(SEAL)

CERTIFICATE OF REGISTRATION

STATE OF OREGON

County of Marion } ss.

This is to certify that the foregoing Registration Statement was received in the office of the State Engineer on the 6 day of January, 1958, at 3:45 o'clock P.M. and has been duly recorded in said office in Book No. 4 of Registration Statements on page 834.

~~Construction shall be completed by _____ and the water completely applied for beneficial use by _____~~

Witness my hand this 5 day of March, 1958.

Lewis A. Stanley
(State Engineer)

By _____ (Deputy)

GR-831 C

30-18