

Registration Statement

OF CLAIMANT OF RIGHT TO APPROPRIATE GROUND WATER

TO THE STATE ENGINEER OF OREGON:

I, J. PETERKORT & COMPANY, a corporation,
of 9755 Southwest Barnes Road County of Washington
(Mailing address)

State of Oregon, do hereby make application for a certificate of registration as evidence
of a right to appropriate ground water.

1. Source from which water is withdrawn is pump well
(Flowing well, pump well, infiltration trench, or tunnel)

2. Location is: 3 miles north and east of Beaverton
(Approximate distance and direction from nearest city or town)

and is more particularly described as follows:

(a) 1070 feet SW from SW Corner of NE 1/4 of Section 2, T15, R1W of E.
(Give distance and bearing to corner of section or other legal subdivision)
being within SE 1/4 of NE 1/4 of SW 1/4 of of Sec. 2 Twp. 1S Rge. 1W
(Smallest legal subdivision) (N. or S.) (E. or W.)

or (b) within limits of recorded platted property, town or city:
in Lot _____, Block _____ of _____
(Name of plat or addition)

County of _____
(If within city or town, give name)

3. Construction Work was begun on March 1933, was completed on May 1933
(Date) (Date)

and the ground water claimed was first used for the purposes set out below on June 1933
(Date)

since which time the water has been used continuously
(Continuously or intermittently)

from June 1933 to present time
(Date) (Date)

4. Quantity of water claimed and used is 40 gallons per minute; _____ acre
feet per year.

5. Purpose or Purposes for which water is used greenhouse irrigation

(Domestic, Irrigation, Municipal, manufacturing, industrial, etc.)

6. Description of Well: Depth 26 feet. Type Drilled
(Dug or drilled)

diameter _____ inches. Elevation of ground at well site 420X feet, mean sea level.
(As near as known)

Depth to water table 90 feet.

7. Capacity of Well: 55 g.p.m. with unknown feet drawdown.

_____ g.p.m. with _____ feet drawdown.

Date of test _____

If Flowing Well: Measured discharge _____ g.p.m. on _____
(Date)

Shut-in pressure at ground surface _____ lbs. per sq. in. on _____
(Date)

Water is controlled by _____
(Cap, valve, etc.)

8. Casing: (Give diameter, commercial specifications and depth below ground surface of each casing size.)

8 inch diameter from 0 1/2 to 200 feet

..... inch diameter from to feet

..... inch diameter from to feet

..... inch diameter from to feet

Describe and show depth of shoe, plug, adapter, liner or other details:

9. Perforated Casings or Screens:

None from to

(Number per foot and size of perforations, or describe screen)

..... from to

..... from to

..... from to

10. Log of Well: (Describe each stratum or formation clearly, indicate if water bearing, and give thickness and depth as indicated.)

| MATERIAL | Thickness (Feet) | Depth to Bottom (Feet) |
|---------------|------------------|------------------------|
| Not available | | |
| | | |
| | | |
| | | |
| | | |
| | | |
| | | |
| | | |
| | | |
| | | |
| | | |
| | | |
| | | |

If log of well is not available, give name and address of driller. A. L. Ziesing (deceased)

11. Infiltration Trench: Covered or open None

Dimensions: Length ft. Minimum depth ft. Maximum depth ft.

Bottom width ft. Discharge g.p.m. Date of test

12. Tunnel: Type of lining None

Dimensions:
(Length, course, and cross sectional size)

Position of water bearing stratum with reference to portal of tunnel

Log of tunnel: (Preceding table for log of well may be used, if desired. Give footage from portal and character of materials, as pertinent.)

13. Pumping Equipment:

(a) Pump Kimball-Krough Deep Well Turbine Capacity 55 g.p.m.
(Make, type and size)


(b) Motor 5 h.p. - 220 volt - single phase
(Type and horsepower)

14. Location of area irrigated or to be irrigated, or place of use if for purposes other than irrigation.

| Township North or South | Range E. or W. of Willamette Meridian | Section | Forty-acre Tract | Number Acres To Be Irrigated | Date of Reclamation |
|----------------------------|--|---------|--|---------------------------------|------------------------|
| T1S | R1W | Sec. 2 | 1-10-20 NE 1/4 of SW 1/4 | Greenhouse and 1 Ac. home | 1933 |
| | | | | | |
| | | | | | |
15. If the ground water supply is supplemental to an existing water supply, identification of any application for a permit, permit, certificate or adjudicated right to appropriate water made or held by the registrant.

Township 1 S Range 1 W W.M.
North

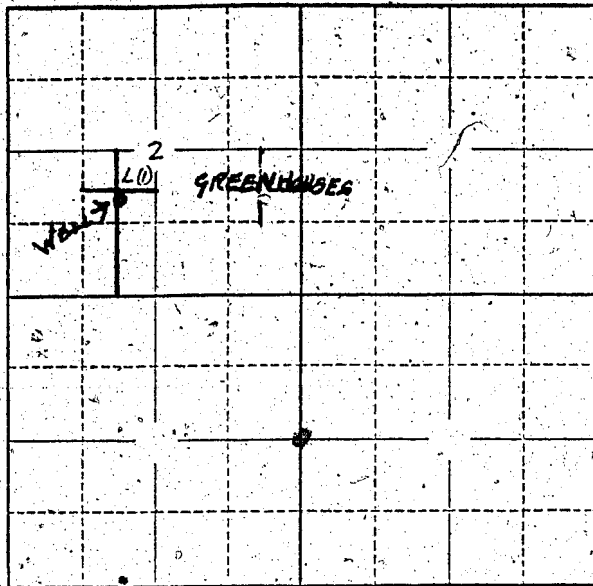

Locate well and acreage of irrigated land on plat.

Scale: 2" = 1 Mile

STATE OF OREGON

County of Multnomah } ss.

I, J. Peterkont, being first duly sworn, do hereby certify that I have read the foregoing Registration Statement and that all of the items therein contained are true to the best of my knowledge and belief. I am President of the registering corporation.

J. Peterkont
(Signature of Registrant)

Subscribed and sworn to before me this 11 day of October, 1957.

My commission expires May 1, 1960

[Signature]
(Notary Public)
Notary Public for Oregon

(SEAL)

CERTIFICATE OF REGISTRATION

STATE OF OREGON

County of Marion } ss.

This is to certify that the foregoing Registration Statement was received in the office of the State Engineer on the 7 day of January, 1958, at 8:00 o'clock A.M. and has been duly recorded in said office in Book No. 5 of Registration Statements on page 835.

Witness my hand this 5 day of March, 1958.

Lewis A. Stanley
(State Engineer)

By _____ (Deputy)