

# Registration Statement

## OF CLAIMANT OF RIGHT TO APPROPRIATE GROUND WATER

TO THE STATE ENGINEER OF OREGON:

I, PETERBORT & COMPANY, a corporation,  
of 9755 Southwest Barnes Road County of Washington  
(Mailing address)

State of Oregon, do hereby make application for a certificate of registration as evidence of a right to appropriate ground water.

1. Source from which water is withdrawn is pump well  
(Flowing well, pump well, infiltration trench, or tunnel)

2. Location is: 3 miles north of Beaverton  
(Approximate distance and direction from nearest city or town)

and is more particularly described as follows:

(a) 500 feet N. E. of the junction of Barnes Road & Sunset Highway  
1320 feet S. of SW corner of NW 1/4 of Section 2, T11S, R1E, W. 1E.  
being within S1/2 of NW 1/4 of SW 1/4 of Sec. 2, Twp. 11S, Rge. 1E  
(Smallest legal subdivision) (N. or S.) (E. or W.)

or (b) within limits of recorded platted property, town or city:  
in Lot \_\_\_\_\_, Block \_\_\_\_\_ of \_\_\_\_\_  
(Name of plat or addition)

County of \_\_\_\_\_  
(If within city or town, give name)

3. Construction Work was begun on April 1946; was completed on July 1947  
(Date) (Date)

and the ground water claimed was first used for the purposes set out below on January 1947  
(Date)

since which time the water has been used continuously  
(Continuously or intermittently)

from January 1947 to present time  
(Date) (Date)

4. Quantity of water claimed and used is 100 gallons per minute; \_\_\_\_\_ acre  
feet per year.

5. Purpose or Purposes for which water is used greenhouse irrigation  
(Domestic, irrigation, municipal, manufacturing, industrial, etc.)

6. Description of Well: Depth 500 feet. Type drilled  
(Dug or drilled)  
diameter 8 inches. Elevation of ground at well site 250 feet, mean sea level.  
(As near as known)  
Depth to water table 120 feet.

7. Capacity of Well: 100 g.p.m. with 150 feet drawdown.  
\_\_\_\_\_ g.p.m. with \_\_\_\_\_ feet drawdown.

Date of test July 1947

If Flowing Well: Measured discharge \_\_\_\_\_ g.p.m. on \_\_\_\_\_  
(Date)


Shut-in pressure at ground surface \_\_\_\_\_ lbs. per sq. in. on \_\_\_\_\_  
(Date)

Water is controlled by \_\_\_\_\_  
(Cap, valve, etc.)





Township.....S..... Range.....W..... W.M.  
North

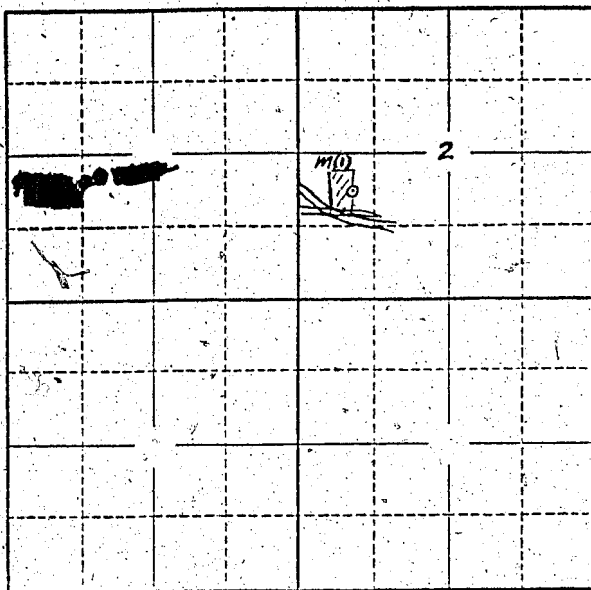

Locate well and acreage of irrigated land on plat.

Scale: 2" = 1 Mile

STATE OF OREGON

County of Multnomah

ss.

I, J. Peterkort, being first duly sworn, do hereby certify that I have read the foregoing Registration Statement and that all of the items therein contained are true to the best of my knowledge and belief. I am president of the registering corporation.

*J. Peterkort*  
(Signature of Registrant)

Subscribed and sworn to before me this 11 day of October, 1957.

My commission expires May 1, 1960.

*[Signature]*  
(Notary Public) Oregon

(SEAL)

CERTIFICATE OF REGISTRATION

STATE OF OREGON

County of Marion

ss.

This is to certify that the foregoing Registration Statement was received in the office of the State Engineer on the 7 day of January, 1958 at 8:00 o'clock A.M. and has been duly recorded in said office in Book No. 5 of Registration Statements on page 836.

Witness my hand this 5 day of March, 1958.

*Laura A. Stanley*  
(State Engineer)

By

(Deputy)