REGISTRATION NO. GR-866
CERTIFICATE NO. GR-839

Registration Statement

OF CLAIMANT OF RIGHT TO APPROPRIATE GROUND WATER

(Under Chapter 708, Oregon Laws 1955.)

TO THE STATE ENGINEER OF OREGON:

I, Rudolph H. Schaad,

of Newberg Rt 3 Box 320 County of Yamhill

State of Oregon, do hereby make application for a certificate of registration as evidence of a right to appropriate ground water.

1. **Source** from which water is withdrawn is Pump Well #1
(Flowing well, pump well, infiltration trench, or tunnel)

2. **Location** is: 3 Miles E of Newberg
(Approximate distance and direction from nearest city or town)

and is more particularly described as follows:

(a) 600 Ft S. & 250 E. of center of Sec. 15
(Give distance and bearing to corner of section or other legal subdivision)

being within NW Quarter of SE Quarter of Sec. 15, Twp. 3 S., Rge. 2 W.
(Smallest legal subdivision) (N. or S.) (E. or W.)

or (b) within limits of recorded platted property, town or city:

in Lot ....., Block ..... of .....
(Name of plat or addition)

..... County of .....
(If within city or town, give name)

3. **Construction Work** was begun on June 1942 (Date); was completed on Aug. 1942 (Date)

and the ground water claimed was first used for the purposes set out below on 1943 (Date),

since which time the water has been used intermittently during season
(Continuously or intermittently)

from 1943 (Date) to 1957 (Date)

4. **Quantity** of water claimed and used is 15 gal gallons per minute; ..... acre feet per year.

5. **Purpose or Purposes** for which water is used ~~Irrig.~~, ~~Garden~~, Nursery
(Domestic, irrigation, municipal, manufacturing, industrial, etc.)

6. **Description of Well:** Depth 140 feet. Type drilled
(Dug or drilled)

diameter 6 inches. Elevation of ground at well site 325 feet, mean sea level.
(As near as known)

Depth to water table 60 feet.

7. **Capacity of Well:** ..... g.p.m. with ..... feet drawdown.

1200 g.p.m. with 100 feet drawdown.

Date of test Aug 1942

If Flowing Well: Measured discharge ..... g.p.m. on .....
(Date)

Shut-in pressure at ground surface ..... lbs. per sq. in. on .....
(Date)

Water is controlled by .....
(Cap, valve, etc.)

8. **Casing:** (Give diameter, commercial specifications and depth below ground surface of each casing size.)

4 inch diameter Steel casing from 0 to 140 feet

inch diameter from to feet

inch diameter from to feet

inch diameter from to feet

Describe and show depth of shoe, plug, adapter, liner or other details:

9. **Perforated Casings or Screens:**

20 Perforations 1/4 wide 4" long from 100 to 140
(Number per foot and size of perforations, or ~~describe screen~~)

from to

from to

from to

10. **Log of Well:** (Describe each stratum or formation clearly, indicate if water bearing, and give thickness and depth as indicated.)

MATERIAL	Thickness (Feet)	Depth to Bottom (Feet)

GR-839 A

If log of well is not available, give name and address of driller. Hoffman Drilling Co

11. **Infiltration Trench:** Covered or open .....

Dimensions: Length ..... ft. Minimum depth ..... ft. Maximum depth ..... ft.

Bottom width ..... ft. Discharge ..... g.p.m. Date of test .....

12. **Tunnel:** Type of lining .....

Dimensions: ..... (Length, course, and cross sectional size)

Position of water bearing stratum with reference to portal of tunnel .....

Log of tunnel: (Preceding table for log of well may be used, if desired. Give footage from portal and character of materials, as pertinent.)

13. **Pumping Equipment:**

(a) Pump Crane No 9 (Make, type and size) Capacity 15 g.p.m.

(b) Motor Helio 7 HP SP (Type and horsepower)

14. Location of area irrigated or to be irrigated, or place of use if for purposes other than irrigation.

Township North or South	Range E. or W. of Willamette Meridian	Section	Forty-acre Tract	Number Acres To Be Irrigated	Date of Reclamation
3 S	2 W	15	NW 1/4 of SE 1/4	1 1/2	1943

15. If the ground water supply is supplemental to an existing water supply, identification of any application for a permit, permit, certificate or adjudicated right to appropriate water made or held by the registrant.

.....

GR-839 B

Township 3 S Range 2 W, W.M.

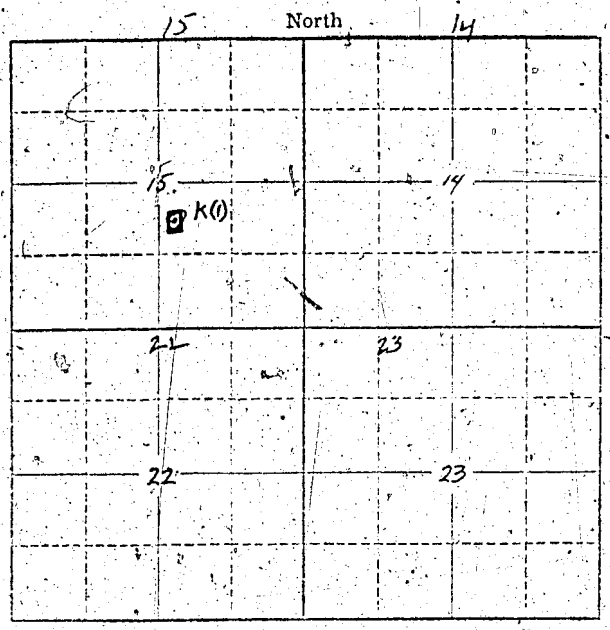

Locate well and acreage of irrigated land on plat.

Scale: 2" = 1 Mile

STATE OF OREGON
County of ..... } ss.

I, ..., being first duly sworn, do hereby certify that I have read the foregoing Registration Statement and that all of the items therein contained are true to the best of my knowledge and belief.

Rudolph A. Schaad
(Signature of Registrant)

Subscribed and sworn to before me this ..... day of ....., 19....

My commission expires .....

(Notary Public)

(SEAL)

CERTIFICATE OF REGISTRATION

STATE OF OREGON
County of Marion } ss.

This is to certify that the foregoing Registration Statement was received in the office of the State Engineer on the 8 day of January, 1958, at 8:00 o'clock A. M. and has been duly recorded in said office in Book No. 5 of Registration Statements on page 839

~~Construction shall be completed by xxxx