

Registration Statement

REGISTRATION NO. GR-847  
CERTIFICATE NO. GR-840

OF CLAIMANT OF RIGHT TO APPROPRIATE GROUND WATER

(Under Chapter 708, Oregon Laws 1955.)

TO THE STATE ENGINEER OF OREGON:

I, Lynn Simon

of Woodburn County of Marion

State of Oregon do hereby make application for a certificate of registration as evidence of a right to appropriate ground water.

1. Source from which water is withdrawn is Pump well  
(Flowing well, pump well, infiltration trench, or tunnel)

2. Location is: 2mi. N. 1mi. W. of Woodburn  
(Approximate distance and direction from nearest city or town)

and is more particularly described as follows:

(a) 2500 feet North and 1700 feet east from SW corner of Section 5  
(Give distance and bearing to corner of section or other legal subdivision)

being within NE 1/4 of SW 1/4 of Sec. 5, Twp. 5S, Rge. 1W  
(Smallest legal subdivision) (N. or S.) (E. or W.)

or (b) within limits of recorded platted property, town or city:

in Lot \_\_\_\_\_, Block \_\_\_\_\_ of \_\_\_\_\_  
(Name of plat or addition)

County of \_\_\_\_\_  
(If within city or town, give name)

3. Construction Work was begun on Oct. 20, 1950 was completed on Nov. 20, 1950  
(Date) (Date)

and the ground water claimed was first used for the purposes set out below on May 1, 1951  
(Date)

since which time the water has been used Continuously  
(Continuously or intermittently)

from May 1, 1951 to Sept. 1957  
(Date) (Date)

4. Quantity of water claimed and used is 300 gallons per minute; \_\_\_\_\_ acre feet per year.

5. Purpose or Purposes for which water is used Irrigation

(Domestic, irrigation, municipal, manufacturing, industrial, etc.)

6. Description of Well: Depth 120 feet. Type Drilled  
(Dug or drilled)  
diameter 10 inches. Elevation of ground at well site 180 feet, mean sea level.  
(As near as known)

Depth to water table 20 feet.

7. Capacity of Well: 300 g.p.m. with 60 feet drawdown.

\_\_\_\_\_ g.p.m. with \_\_\_\_\_ feet drawdown.

Date of test Nov. 20, 1950

If Flowing Well: Measured discharge no g.p.m. on \_\_\_\_\_  
(Date)

Shut-in pressure at ground surface \_\_\_\_\_ lbs. per sq. in. on \_\_\_\_\_  
(Date)

Water is controlled by \_\_\_\_\_  
(Cap, valve, etc.)

8. Casing: (Give diameter, commercial specifications and depth below ground surface of each casing size.)

10 inch diameter *Steel casing* from 0 to 120 feet  
 inch diameter from to feet  
 inch diameter from to feet  
 inch diameter from to feet

Describe and show depth of shoe, plug, adapter, liner or other details:

9. Perforated Casings or Screens:

*yes - Mills Knife* from 100 to 118  
 (Number per foot and size of perforations, or describe screen)  
 from to  
 from to  
 from to

10. Log of Well: (Describe each stratum or formation clearly, indicate if water bearing, and give thickness and depth as indicated.)

MATERIAL	Thickness (Feet)	Depth to Bottom (Feet)
<i>Top soil</i>	<i>3</i>	<i>3</i>
<i>silt + clay, yellow</i>	<i>23</i>	<i>26</i>
<i>clay, blue</i>	<i>26</i>	<i>78</i>
<i>sand, black</i>	<i>78</i>	<i>90</i>
<i>clay, blue</i>	<i>90</i>	<i>100</i>
<i>sand, black</i>	<i>100</i>	<i>116</i>
<i>sand &amp; gravel</i>	<i>116</i>	<i>120</i>
<i>Gravel pack 1/4" + 1/2" gravel</i>		

If log of well is not available, give name and address of driller.

Roy Perkins Salem, Oregon

11. Infiltration Trench: Covered or open

Dimensions: Length ..... ft. Minimum depth ..... ft. Maximum depth ..... ft. Bottom width ..... ft. Discharge ..... g.p.m. Date of test .....

12. Tunnel: Type of lining .....

Dimensions: ..... (Length, course, and cross sectional size)

Position of water bearing stratum with reference to portal of tunnel .....

Log of tunnel: (Preceding table for log of well may be used, if desired. Give footage from portal and character of materials, as pertinent.)

13. Pumping Equipment:

(a) Pump Peerles Turbine Capacity 300 g.p.m. (Make, type and size)

(b) Motor 25 H.P. U.S. motor (Type and horsepower)


14. Location of area irrigated or to be irrigated, or place of use if for purposes other than irrigation.

Township North or South	Range E. or W. of Willamette Meridian	Section	Forty-acre Tract	Number Acres To Be Irrigated	Date of Reclamation
T5S	R1W	5	SW 1/4 of NW 1/4	12	May 1, 1951
"	"	5	SE 1/4 of NW 1/4	31	"
"	"	5	NW 1/4 of SW 1/4	8	"
"	"	6	NE 1/4 of SW 1/4	9	"
				60 Total	

15. If the ground water supply is supplemental to an existing water supply, identification of any application for a permit, permit, certificate or adjudicated right to appropriate water made or held by the registrant.

Certificate No. 14431

Township 55 Range 1W W.M.  
North

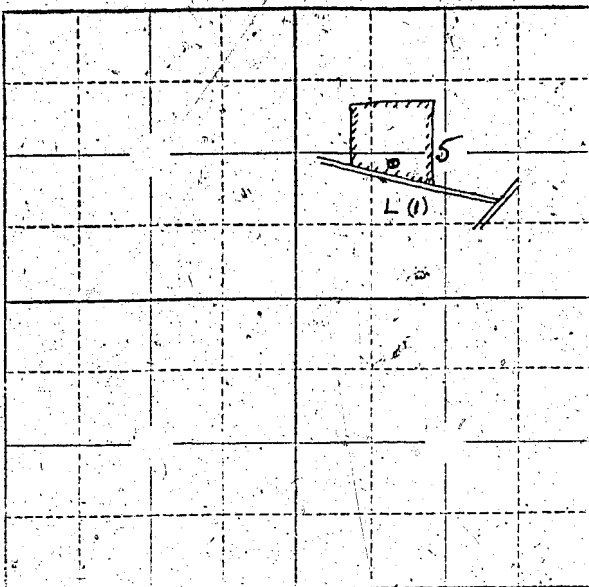

Locate well and acreage of irrigated land on plat.

Scale: 2" = 1 Mile

STATE OF OREGON

County of Marion

ss.

I, \_\_\_\_\_, being first duly sworn, do hereby certify that I have read the foregoing Registration Statement and that all of the items therein contained are true to the best of my knowledge and belief.

Lynn Simon  
(Signature of Registrant)

Subscribed and sworn to before me this 8th day of January, 1958

My commission expires June 12th, 1961

Wm. S. Bartholomew  
(Notary Public)

(SEAL)

**CERTIFICATE OF REGISTRATION**

STATE OF OREGON

County of Marion

ss.

This is to certify that the foregoing Registration Statement was received in the office of the State Engineer on the 7 day of January, 1958, at 10:00 o'clock A.M. and has been duly recorded in said office in Book No. 5 of Registration Statements on page 810

~~Construction shall be completed by \_\_\_\_\_ 19\_\_\_\_ and the water completely applied to the beneficial uses by \_\_\_\_\_ 19\_\_\_\_~~

Witness my hand this 5 day of March, 1958

Laura A. Straley  
(State Engineer)

By \_\_\_\_\_  
(Deputy)

GR-810C