

Registration Statement

REGISTRATION NO. GR-869
 CERTIFICATE NO. GR-842

OF CLAIMANT OF RIGHT TO APPROPRIATE GROUND WATER

(Under Chapter 708, Oregon Laws 1955.)

TO THE STATE ENGINEER OF OREGON:

I, John Fery
 of Route 1, Box 24, Stayton County of Marion
 State of Oregon, do hereby make application for a certificate of registration as evidence
 of a right to appropriate ground water.

1. Source from which water is withdrawn is Pump Well
 (Flowing well, pump well, infiltration trench, or tunnel)

2. Location is: _____
 (Approximate distance and direction from nearest city or town)

(and is more particularly described as follows:

N. 63° 59' East 7.320 chains to the 1/4 cor. common to Sec. 14 & 15

(a) T. 2 S. R. 1 W. E. 4
 (Give distance and bearing to corner of section or other legal subdivision)

being within NE 1/4 of SE 1/4 of Sec. 15, Twp. 9 S., Rge. 1 W.
 (Smallest legal subdivision) (N. or S.) (E. or W.)

or (b) within limits of recorded platted property, town or city: _____

in Lot _____, Block _____ of _____
 (Name of plat or addition)

County of _____
 (If within city or town, give name)

3. Construction Work was begun on Sept. 1951; was completed on Sept. 1951
 (Date) (Date)

and the ground water claimed was first used for the purposes set out below on May 15, 1951
 (Date)

since which time the water has been used continuously
 (Continuously or Intermittently)

from May 15 to Oct. 1
 (Date) (Date)

4. Quantity of water claimed and used is 260 gpm 26 sprinklers gallons per minute; _____ acre
 feet per year.

5. Purpose or Purposes for which water is used Irrigation

(Domestic, irrigation, municipal, manufacturing, industrial, etc.)

6. Description of Well: Depth 21 feet. Type drilled
 (Dug or drilled)

diameter: 10 inches. Elevation of ground at well site 330 feet, mean sea level.
 (As near as known)

Depth to water table 10 feet.

7. Capacity of Well: 600 g.p.m. with 8 feet drawdown.

g.p.m. with _____ feet drawdown.

Date of test any time

If Flowing Well: Measured discharge _____ g.p.m. on _____
 (Date)

Shut-in pressure at ground surface _____ lbs. per sq. in. on _____
 (Date)

Water is controlled by _____
 (Cap, valve, etc.)

10	inch diameter	from 0	to 21	feet
	inch diameter	from	to	feet
	inch diameter	from	to	feet
	inch diameter	from	to	feet

Describe and show depth of shoe, plug, adapter, liner or other details:

I do not know from 10' to 20'

(Number per foot and size of perforations, or describe screen)

from to

from to

from to

from to

GR-842 A

If log of well is not available, give name and address of driller.

11. Infiltration Trench: Covered or open

Dimensions: Length ft. Minimum depth ft. Maximum depth ft.

Bottom width ft. Discharge g.p.m. Date of test

12. Tunnel: Type of lining

Dimensions:
(Length, course, and cross sectional size)

Position of water bearing stratum with reference to portal of tunnel

Log of tunnel: (Preceding table for log of well may be used, if desired. Give footage from portal and character of materials, as pertinent.)

13. Pumping Equipment:

(a) Pump Centrifugal 4" suction 4" Capacity 200 g.p.m.
(Make, type and size)

(b) Motor 10 H.P. Electric 3 phase
(Type and horsepower)

14. Location of area irrigated or to be irrigated, or place of use if for purposes other than irrigation.

Township North or South	Range E. or W. of Willamette Meridian	Section	Forty-acre Tract	Number Acres To Be Irrigated	Date of Reclamation
9 S.	1 W.	14	SW $\frac{1}{4}$ of NW $\frac{1}{4}$	0.42	May 1951
"	"	"	NW $\frac{1}{4}$ of SW $\frac{1}{4}$	8.9	"
"	"	15	SE $\frac{1}{4}$ of NE $\frac{1}{4}$	5.6	"
"	"	"	NE $\frac{1}{4}$ of SE $\frac{1}{4}$	7.1	"
				22.02	


Beginning at the quarter corner on the East line of Section 15 in Township 9 South Range 1 West of the Willamette Meridian in Linn County, Oregon; thence S. 89° 43' W. along the North line of the Southeast quarter of said Section 15, 10.338 chains; thence South 5.505 chains to the center of the Stayton-Kingston County Road; thence S. 67° 52' E. along the center of said County Road 6.292 chains; thence S. 77° 27' E. along the center of said County Road 4.517 chains to the East line of said Section 15; thence North along said East line 8.940 chains to the place of beginning and containing 7.696 acres of land.

RESERVING for Road and right-of-way purposes a strip of land 30.00 feet in width off the Southerly side of the above described tract.

15. If the ground water supply is supplemental to an existing water supply, identification of any application for a permit, permit, certificate or adjudicated right to appropriate water made or held by the registrant.

GR-312B

Township 9S Range 1W W.M.
North

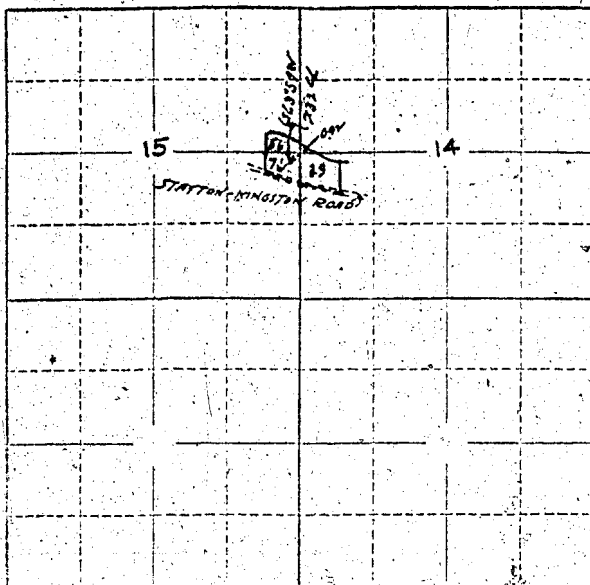

Locate well and acreage of irrigated land on plat.

Scale: 2" = 1 Mile

STATE OF OREGON

County of Marion

ss.

I, John Ferry, being first duly sworn, do hereby certify that I have read the foregoing Registration Statement and that all of the items therein contained are true to the best of my knowledge and belief.

John Ferry
(Signature of Registrant)

Subscribed and sworn to before me this 10th day of January, 1958

My commission expires

NOTARY PUBLIC FOR OREGON
MY COMMISSION EXPIRES SEP. 17, 1964

Ernest A. Lee
(Notary Public)

(SEAL)

CERTIFICATE OF REGISTRATION

STATE OF OREGON

County of Marion

ss.

This is to certify that the foregoing Registration Statement was received in the office of the State Engineer on the 10 day of January, 1958, at 8:00 o'clock A. M. and has been duly recorded in said office in Book No. 5 of Registration Statements on page 842

~~Construction shall be completed by~~ 1958 ~~and the water completely applied to~~
~~beneficial use by~~ 1958

Witness my hand this 5 day of March, 1958

Lewis A. Stanley
(State Engineer)

By

(Deputy)

GR-842 C