

# Registration Statement

## OF CLAIMANT OF RIGHT TO APPROPRIATE GROUND WATER

### TO THE STATE ENGINEER OF OREGON:

I, Ed. Spröck

of 1997 Tepper Lane, Salem County of Marion  
(Mailing address)

State of Oregon, do hereby make application for a certificate of registration as evidence of a right to appropriate ground water.

1. Source from which water is withdrawn is Pump well  
(Flowing well, pump well, infiltration trench, or tunnel)

2. Location is: 1 1/2 miles Northeast of Keizer  
(Approximate distance and direction from nearest city or town)

and is more particularly described as follows:

(a) South 1272 feet and East 1576 feet from Northwest corner section 36  
(Give distance and bearing to corner of section or other legal subdivision)

being within Northeast quarter of Sec. 39, Twp. 6 South, Rge. 3 West  
(Smallest legal subdivision) (N. or S.) (E. or W.)

or (b) within limits of recorded platted property, town or city:

in Lot \_\_\_\_\_ Block \_\_\_\_\_ of \_\_\_\_\_  
(Name of plat or addition)

County of \_\_\_\_\_  
(If within city or town, give name)

3. Construction Work was begun on Spring 1951; was completed on Spring 1951  
(Date) (Date)

and the ground water claimed was first used for the purposes set out below on May 1951  
(Date)

since which time the water has been used Intermittently during season  
(Continuously or intermittently)

from May 1951 to Oct. 1957  
(Date) (Date)

4. Quantity of water claimed and used is 260 gallons per minute; \_\_\_\_\_ acre feet per year.

5. Purpose or Purposes for which water is used irrigation

(Domestic, irrigation, municipal, manufacturing, industrial, etc.)

6. Description of Well: Depth 80 feet. Type Drilled  
(Dug or drilled)

diameter 8 inches. Elevation of ground at well site \_\_\_\_\_ feet, mean sea level.  
(As near as known)

Depth to water table 20 feet.

7. Capacity of Well: 260 g.p.m. with 40 feet drawdown.

\_\_\_\_\_ g.p.m. with \_\_\_\_\_ feet drawdown.

Date of test During Pump operation

If Flowing Well: Measured discharge \_\_\_\_\_ g.p.m. on \_\_\_\_\_  
(Date)

Shut-in pressure at ground surface \_\_\_\_\_ lbs. per sq. in. on \_\_\_\_\_  
(Date)

Water is controlled by \_\_\_\_\_  
(Cap. valve, etc.)

8. Casing: (Give diameter, commercial specifications and depth below ground surface of each casing size.)

8 inch diameter steel casing from 0 to 70 feet  
 inch diameter from to feet  
 inch diameter from to feet  
 inch diameter from to feet

Describe and show depth of shoe, plug, adapter, liner or other details:

9. Perforated Casings or Screens:

yes (Number per foot and size of perforations, or describe screen) from 40 to 70  
 from to  
 from to  
 from

10. Log of Well: (Describe each stratum or formation clearly, indicate if water bearing, and give thickness and depth as indicated.)

MATERIAL	Thickness (Feet)	Depth to Bottom (Feet)
<u>sand &amp; gravel</u>		
<u>unknown</u>		

If log of well is not available, give name and address of driller. ....

11. Infiltration Trench: Covered or open .....

Dimensions: Length ..... ft. Minimum depth ..... ft. Maximum depth ..... ft.

Bottom width ..... ft. Discharge ..... g.p.m. Date of test .....

12. Tunnel: Type of lining .....

Dimensions: .....  
(Length, course, and cross sectional size)

Position of water bearing stratum with reference to portal of tunnel .....

Log of tunnel: (Preceding table for log of well may be used, if desired. Give footage from portal and character of materials, as pertinent.)

13. Pumping Equipment:

(a) Pump *Turbine* ..... Capacity *275* g.p.m.  
(Make, type and size)


(b) Motor *15HP* .....  
(Type and horsepower)

14. Location of area irrigated or to be irrigated, or place of use if for purposes other than irrigation.

Township North or South	Range E. or W. of Willamette Meridian	Section	Forty-acre Tract	Number Acres To Be Irrigated	Date of Reclamation
6 South	3 West	36	N.W. $\frac{1}{4}$ of N. W. $\frac{1}{4}$	0.9	May 1951
6 South	3 West	36	N.E. $\frac{1}{4}$ of N.W. $\frac{1}{4}$	1.4	" "
6 South	3 West	36	S.W. $\frac{1}{4}$ of N. W. $\frac{1}{4}$	2.7	" "
6 South	3 West	36	S.E. $\frac{1}{4}$ of N. W. $\frac{1}{4}$	14.1	" "
				26.1 Total	" "

15. If the ground water supply is supplemental to an existing water supply; identification of any application for a permit, permit, certificate or adjudicated right to appropriate water made or held by the registrant.

Township 65 Range 3W, W.M.  
North

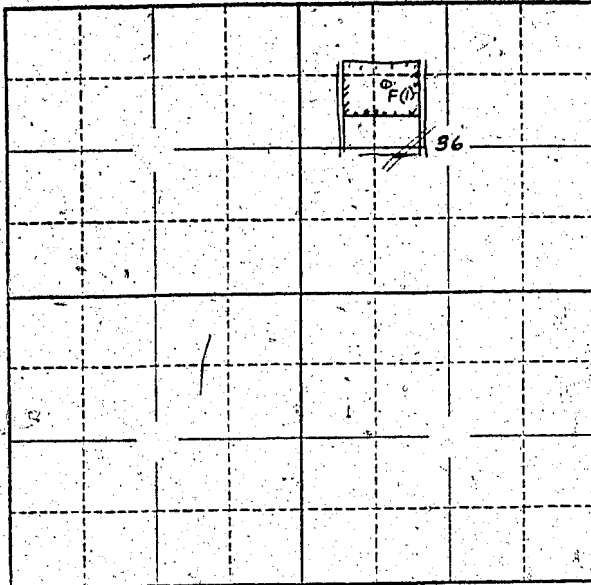

Locate well and acreage of irrigated land on plat.

Scale: 2" = 1 Mile

STATE OF OREGON

County of Marion

} ss.

I, \_\_\_\_\_, being first duly sworn, do hereby certify that I have read the foregoing Registration Statement and that all of the items therein contained are true to the best of my knowledge and belief.

*Ed Spind*  
(Signature of Registrant)

Subscribed and sworn to before me this 13<sup>th</sup> day of January, 1958

My commission expires June 12th, 1961

*Wm. S. Bartholomew*  
(Notary Public)

(SEAL)

### CERTIFICATE OF REGISTRATION

STATE OF OREGON

County of Marion

} ss.

This is to certify that the foregoing Registration Statement was received in the office of the State Engineer on the 13<sup>th</sup> day of January, 1958, at 8:00 o'clock A.M. and has been duly recorded in said office in Book No. 5 of Registration Statements on page 845

Witness my hand this 5 day of March, 1958

\$15.00

*Lewis A. Stanley*  
(State Engineer)

By \_\_\_\_\_  
(Deputy)

GR - 845 C