

Registration Statement

OF CLAIMANT OF RIGHT TO APPROPRIATE GROUND WATER

TO THE STATE ENGINEER OF OREGON:

I, JOE RYAN

of Rt. 1, Box 104, Gervais County of Marion

State of Oregon, do hereby make application for a certificate of registration as evidence of a right to appropriate ground water.

1. Source from which water is withdrawn is pump well #1
(Flowing well, pump well, infiltration trench, or tunnel)

2. Location is: Approximately 2 miles East Wheatland Ferry
(Approximate distance and direction from nearest city or town)

and is more particularly described as follows:

(a) 500 feet west and 120 feet south from S.E. corner of Section 35
(Give distance and bearing to corner of section or other legal subdivision)

being within NE 1/4 of NE 1/4 of Sec. 52, Twp. 6S, Rge. 5W
(Smallest legal subdivision) (N. or S.) (E. or W.)

or (b) within limits of recorded platted property, town or city:

in Lot _____, Block _____ of _____
(Name of plat or addition)

County of _____
(If within city or town, give name)

3. Construction Work was begun on Aug. 1947; was completed on August 7, 1947
(Date) (Date)

and the ground water claimed was first used for the purposes set out below on soon after
(Date)

since which time the water has been used intermittently
(Continuously or Intermittently)

from summer irrigation to Oct. 1957
(Date) (Date)

4. Quantity of water claimed and used is 450 gallons per minute; X acre feet per year.

5. Purpose or Purposes for which water is used irrigation

(Domestic, irrigation, municipal, manufacturing, industrial, etc.)

6. Description of Well: Depth 43 feet. Type drilled
(Dug or drilled)

diameter 10 inches. Elevation of ground at well site 41 feet, mean sea level.
(As near as known)

Depth to water table 22 feet.

7. Capacity of Well: 400 g.p.m. with 2 feet drawdown.

_____ g.p.m. with _____ feet drawdown.

Date of test time well dug

If Flowing Well: Measured discharge _____ g.p.m. on _____ (Date)

Shut-in pressure at ground surface _____ lbs. per sq. in. on _____ (Date)

Water is controlled by _____
(Cap, valve, etc.)

8. Casing: (Give diameter, commercial specifications and depth below ground surface of each casing size.)

..... inch diameter see below from to feet
 inch diameter from to feet
 inch diameter from to feet
 inch diameter from to feet

Describe and show depth of shoe, plug, adapter, liner or other details:

9. Perforated Casings or Screens:

(Number per foot and size of perforations, or describe screen) from to
 from to
 from to
 from to

10. Log of Well: (Describe each stratum or formation clearly, indicate if water bearing, and give thickness and depth as indicated.)

MATERIAL	Thickness (Feet)	Depth to Bottom (Feet)
Formation 0' - 3' topsoil		
3' -- 20' Heavy soil		
20' - 25' Sand water bearing		
25' -- 33' Sand & small gravel		
33' - 43' Heavy gravel water bearing		
Casing? 10 ft. perforation, 5 perforation to ft. each 5 inches long and 1/2 in. wide		
perforated from 33 ft. to 43 ft.		

If log of well is not available, give name and address of driller.

11. Infiltration Trench: Covered or open

Dimensions: Length ft. Minimum depth ft. Maximum depth ft.

Bottom width ft. Discharge g.p.m. Date of test

12. Tunnel: Type of lining

Dimensions:
(Length, course, and cross sectional size)

Position of water bearing stratum with reference to portal of tunnel

Log of tunnel: (Preceding table for log of well may be used, if desired. Give footage from portal and character of materials, as pertinent.)

13. Pumping Equipment:

(a) Pump 4" Fairbanks Morse Pump Capacity 450 g.p.m.
(Make, type and size)

(b) Motor International U 4 gas motor
(Type and horsepower)


14. Location of area irrigated or to be irrigated, or place of use if for purposes other than irrigation.

Township North or South	Range E or W of Willametta Meridian	Section	Forty-acre Tract	Number Acres To Be Irrigated	Date of Reclamation
T5S	R3W	35	SE $\frac{1}{4}$ of SE $\frac{1}{4}$	30.5	Aug. 1947
"	"	"	SW $\frac{1}{4}$ of SE $\frac{1}{4}$	29.5	" "
"	"	"	NW $\frac{1}{4}$ of SE $\frac{1}{4}$	7.00	" "
"	"	"	NE $\frac{1}{4}$ of SE $\frac{1}{4}$	2.5	" "
T6S	R3W	2	NE $\frac{1}{4}$ of NE $\frac{1}{4}$	6.0	" "
"	"	2	NW $\frac{1}{4}$ of NE $\frac{1}{4}$	6.0	" "
"	"	2	NE $\frac{1}{4}$ of NW $\frac{1}{4}$	14.0	" "
T5S	R3W	36	SW $\frac{1}{4}$ of SW $\frac{1}{4}$	10.0	" "
T6S	R3W	1	NE $\frac{1}{4}$ of NW $\frac{1}{4}$	10.0	" "
T6S	R3W	1	SE $\frac{1}{4}$ of NW $\frac{1}{4}$	6.0	" "
				100.0	

15. If the ground water supply is supplemental to an existing water supply, identification of any application for a permit, permit, certificate or adjudicated right to appropriate water made or held by the registrant.

See 10067 Permit 13815 Cont. 10065

Township 6 S Range 3 W W.M.
North

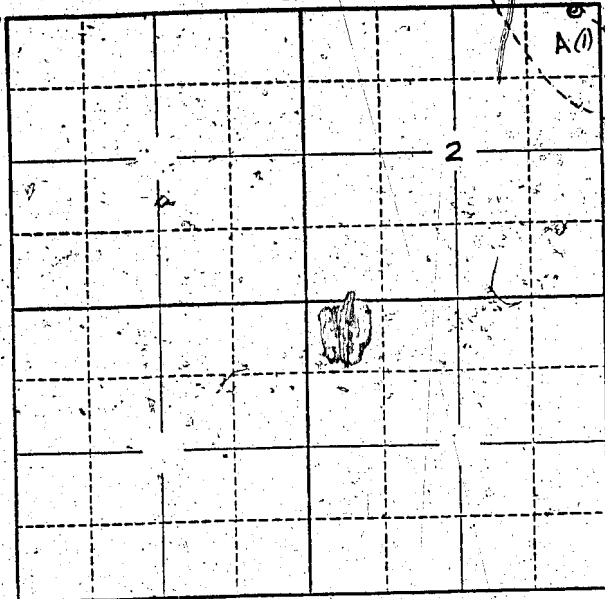

Locate well and acreage of irrigated land on plat.
Scale: 2" = 1 Mile

STATE OF OREGON

County of Marion

} ss.

I, Joe Ryan, being first duly sworn, do hereby certify that I have read the foregoing Registration Statement and that all of the items therein contained are true to the best of my knowledge and belief.

Joe Ryan
(Signature of Registrant)

Subscribed and sworn to before me this 13th day of January, 1958

My commission expires May 10, 1959

Carl [Signature]
(Notary Public)

(SEAL)

CERTIFICATE OF REGISTRATION

STATE OF OREGON

County of Marion

} ss.

This is to certify that the foregoing Registration Statement was received in the office of the State Engineer on the 13 day of January, 1958, at 6:00 o'clock A.M. and has been duly recorded in said office in Book No. 5 of Registration Statements on page 817.

Witness my hand this 24 day of April, 1958

Lewis A. Stanley
(State Engineer)

By _____
(Deputy)

GR - 847 C