REGISTRATION NO. GR-876

CERTIFICATE NO. GR-849

Registration Statement

OF CLAIMANT OF RIGHT TO APPROPRIATE GROUND WATER

(Under Chapter 708, Oregon Laws 1955.)

TO THE STATE ENGINEER OF OREGON:

I, [illegible]

of [illegible] County of [illegible]

State of [illegible], do hereby make application for a certificate of registration as evidence of a right to appropriate ground water.

1. **Source** from which water is withdrawn is [illegible] #1
(Flowing well, pump well, infiltration trench, or tunnel)

2. **Location is:** [illegible]
(Approximate distance and direction from nearest city or town)

and is more particularly described as follows:

(a) 903 South [illegible]
(Give distance and bearing to corner of section or other legal subdivision)

being within SW¼ of NW¼ of Sec. [illegible], Twp. [illegible] (N. or S.), Rge. [illegible] (E. or W.)
(Smallest legal subdivision)

or (b) within limits of recorded platted property, town or city: [illegible]

in Lot [illegible], Block [illegible], of [illegible]
(Name of plat or addition)

[illegible] County of [illegible]
(If within city or town, give name)

3. **Construction Work** was begun on [illegible] (Date); was completed on [illegible] (Date)

and the ground water claimed was first used for the purposes set out below on [illegible] (Date),

since which time the water has been used [illegible]
(Continuously or intermittently)

from [illegible] (Date) to [illegible] (Date)

4. **Quantity** of water claimed and used is [illegible] gallons per minute; [illegible] acre feet per year.

5. **Purpose or Purposes** for which water is used [illegible]
(Domestic, irrigation, municipal, manufacturing, industrial, etc.)

6. **Description of Well:** Depth [illegible] feet. Type [illegible] (Dug or drilled)

diameter [illegible] inches. Elevation of ground at well site 405 (As near as known) feet, mean sea level.

Depth to water table [illegible] feet.

7. **Capacity of Well:** [illegible] g.p.m. with [illegible] feet drawdown.

[illegible] g.p.m. with [illegible] feet drawdown.

Date of test [illegible]

If Flowing Well: Measured discharge [illegible] g.p.m. on [illegible] (Date)

Shut-in pressure at ground surface [illegible] lbs. per sq. in. on [illegible] (Date)

Water is controlled by [illegible]
(Cap, valve, etc.)

8. **Casing:** (Give diameter, commercial specifications and depth below ground surface of each casing size.)

4 inch diameter from 0 to 21 feet

..... inch diameter from ..... to ..... feet

..... inch diameter from ..... to ..... feet

..... inch diameter from ..... to ..... feet

Describe and show depth of shoe, plug, adapter, liner or other details: .....

9. **Perforated Casings or Screens:**

2 perforations per foot from ..... to .....
(Number per foot and size of perforations, or description)

..... from ..... to .....

..... from ..... to .....

..... from ..... to .....

10. **Log of Well:** (Describe each stratum or formation clearly, indicate if water bearing, and give thickness and depth as indicated.)

MATERIAL	Thickness (Feet)	Depth to Bottom (Feet)

GR- 8.55 A

If log of well is not available, give name and address of driller. .....

.....

11. **Infiltration Trench:** Covered or open .....

Dimensions: Length ..... ft. Minimum depth ..... ft. Maximum depth ..... ft.

Bottom width ..... ft. Discharge ..... g.p.m. Date of test .....

12. **Tunnel:** Type of lining .....

Dimensions: .....
(Length, course, and cross sectional size)

Position of water bearing stratum with reference to portal of tunnel .....

.....

Log of tunnel: (Preceding table for log of well may be used, if desired. Give footage from portal and character of materials, as pertinent.)

13. **Pumping Equipment:**

(a) Pump Fairbanks Morse .....
(Make, type and size)
Capacity ..... g.p.m.

(b) Motor .....
(Type and horsepower)

14. Location of area irrigated or to be irrigated, or place of use if for purposes other than irrigation.

Township North or South	Range E. or W. of Willamette Meridian	Section	Forty-acre Tract	Number Acres To Be Irrigated	Date of Reclamation
South	[illegible]	9		[illegible]	[illegible]
17S	3W	9	SW¼ of NW¼	20.0	" "
"	"	9	NW¼ of SW¼	7.8	" "
				27.8	

15. If the ground water supply is supplemental to an existing water supply, identification of any application for a permit, permit, certificate or adjudicated right to appropriate water made or held by the registrant.

.....

.....

GR- 849 B

Township 17 S Range 3W, W.M.

North

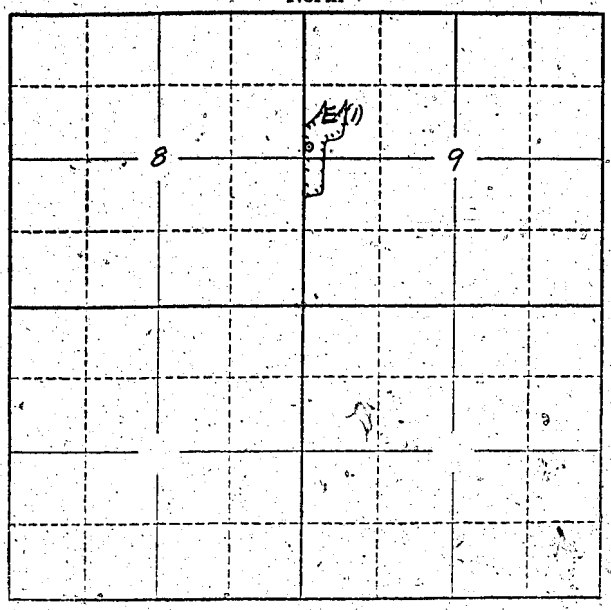

Locate well and acreage of irrigated land on plat.

Scale: 2" = 1 Mile

STATE OF OREGON
County of Lane } ss.

I, Vernon S. Johnson, being first duly sworn, do hereby certify that I have read the foregoing Registration Statement and that all of the items therein contained are true to the best of my knowledge and belief.

(Signature of Registrant)

Subscribed and sworn to before me this 16th day of January, 19 58

My commission expires 3-13-61

(Notary Public)

(SEAL)

CERTIFICATE OF REGISTRATION

STATE OF OREGON
County of Marion } ss.

This is to certify that the foregoing Registration Statement was received in the office of the State Engineer on the 14th day of January, 19 58, at 2 o'clock M. and has been duly recorded in said office in Book No. 5 of Registration Statements on page 849

~~Construction shall be completed by x-x-x-x-x-x-x-x-x-x, 19x-x-, and the water completely applied to beneficial use by x-x-x-x-x-x-x-x-x-x, 19x-x-xx~~

Witness my hand this 24 day of April, 19 58.

(State Engineer)

By (Deputy)

GR-849 C