

# Registration Statement

REGISTRATION NO. GR 878  
CERTIFICATE NO. GR-852

## OF CLAIMANT OF RIGHT TO APPROPRIATE GROUND WATER

(Under Chapter 708, Oregon Laws 1955.)

TO THE STATE ENGINEER OF OREGON:

State of Oregon, do hereby make application for a certificate of registration as evidence  
of a right to appropriate ground water.

1. Source from which water is withdrawn is Flowing well #1  
(Flowing well, pump well, infiltration trench, or tunnel)

(Approximate distance and direction from nearest city or town)

and is more particularly described as follows:


(Smallest legal subdivision) (N. or S.) (E. or W.)

or (b) within limits of recorded platted property, town or city:  
(Name of plat or addition)

(If within city or town, give name)  










8. Casing: (Give diameter, commercial specifications and depth below ground surface of each casing size.)

3'-2" inch diameter ..... *PIPE* ..... from 0 to 20 feet  
..... inch diameter ..... from ..... to ..... feet  
..... inch diameter ..... from ..... to ..... feet  
..... inch diameter ..... from ..... to ..... feet

Describe and show depth of shoe, plug, adapter, liner or other details:  
.....  
.....

9. Perforated Casings or Screens:

(Number per foot and size of perforations, or describe screen) ..... from ..... to .....  
..... from ..... to .....  
..... from ..... to .....  
..... from ..... to .....

10. Log of Well: (Describe each stratum or formation clearly, indicate if water bearing, and give thickness and depth as indicated.)

MATERIAL	Thickness (Feet)	Depth to Bottom (Feet)

If log of well is not available, give name and address of driller: .....

**11. Infiltration Trench: Covered or open** .....

Dimensions: Length ..... ft. Minimum depth ..... ft. Maximum depth ..... ft.

Bottom width ..... ft. Discharge ..... g.p.m. Date of test .....

**12. Tunnel: Type of lining** .....

Dimensions: .....  
(Length, course, and cross sectional size)

Position of water bearing stratum with reference to portal of tunnel .....

Log of tunnel: (Preceding table for log of well may be used, if desired. Give footage from portal and character of materials, as pertinent.)

**13. Pumping Equipment:**

(a) Pump ..... Capacity ..... g.p.m.  
(Make, type and size)


(b) Motor .....  
(Type and horsepower)

**14. Location of area irrigated or to be irrigated, or place of use if for purposes other than irrigation.**

Township North or South	Range E. or W. of Willamette Meridian	Section	Forty-acre Tract	Number Acres To Be Irrigated	Date of Reclamation
			SW <sup>1</sup> / <sub>4</sub> + SW <sup>1</sup> / <sub>4</sub>		

15. If the ground water supply is supplemental to an existing water supply, identification of any application for a permit, permit, certificate or adjudicated right to appropriate water made or held by the registrant.

Township 17S Range R. 3W, W.M.  
North

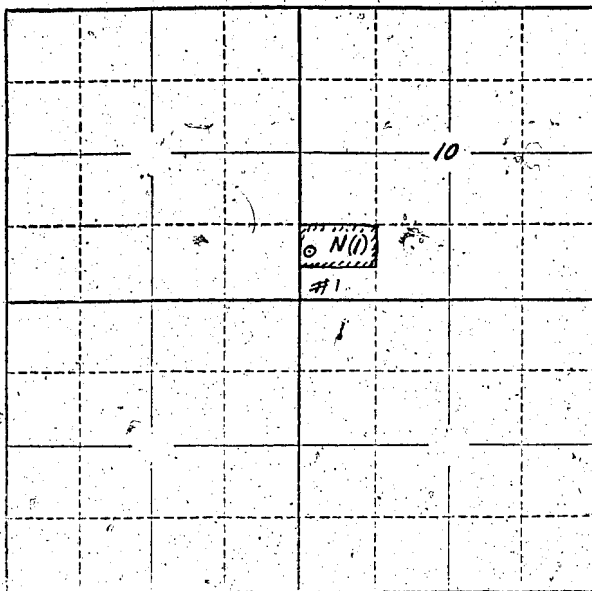

Locate well and acreage of irrigated land on plat.  
Scale: 2" = 1 Mile

STATE OF OREGON

County of Linn } ss.

I, Wesley S. Johnson, being first duly sworn, do hereby certify that I have read the foregoing Registration Statement and that all of the items therein contained are true to the best of my knowledge and belief.

Wesley S. Johnson  
\_\_\_\_\_  
(Signature of Registrant)

Subscribed and sworn to before me this 1 day of April, 1958.

My commission expires 12-31-61 \_\_\_\_\_  
(Notary Public)

(SEAL)

**CERTIFICATE OF REGISTRATION**

STATE OF OREGON

County of Marion } ss.

This is to certify that the foregoing Registration Statement was received in the office of the State Engineer on the 1st day of April, 1958, at \_\_\_\_\_ o'clock \_\_\_\_\_ M. and has been duly recorded in said office in Book No. 5 of Registration Statements on page 50.

Construction shall be completed by ~~XXXXXX~~ 1958 and the water completely applied to beneficial use by ~~XXXXXX~~ 1958.

Witness my hand this 24 day of April, 1958.

Arthur J. [Signature]  
\_\_\_\_\_  
(State Engineer)

By \_\_\_\_\_  
(Deputy)

GR-852 C