

RECEIVED
JAN 25 1956

STATE ENGINEER
SALEM, OREGON

Registration Statement

REGISTRATION NO. GR-88

CERTIFICATE NO. GR-74

OF CLAIMANT OF RIGHT TO APPROPRIATE GROUND WATER

(Under Chapter 708, Oregon Laws 1955.)

TO THE STATE ENGINEER OF OREGON:

I, EMIL B. SCHLIMMEIER,

of CORVALLIS County of BENTON

State of OREGON, do hereby make application for a certificate of registration as evidence of a right to appropriate ground water:

1. Source from which water is withdrawn is PUMP WELL

(Flowing well, pump well, infiltration trench, or tunnel)

2. Location is: 3 M. N.E. CORVALLIS HI. WAY # 20

(Approximate distance and direction from nearest city or town)

and is more particularly described as follows:

(a) 13 chains South and 18 chains West of NE corner section 19

(Give distance and bearing to corner of section or other legal subdivision)

being within NE 1/4 of NE 1/4 of Sec. 17, Twp. 11 S., Rge. 4 W.

(Smallest legal subdivision)

(N. or S.)

(E. or W.)

or (b) within limits of recorded platted property, town or city:

in Lot _____, Block _____ of _____

(Name of plat or addition)

County of _____

(If within city or town, give name)

3. Construction Work was begun on OCT. 20 - 1950, was completed on OCT. 27 - 1950

(Date)

(Date)

and the ground water claimed was first used for the purposes set out below on APRIL 15 - 1951,

(Date)

since which time the water has been used INTERMITTENTLY.

(Continuously or Intermittently)

from APRIL 15 - 1951 to SEPT. 20 - 1952

(Date)

(Date)

4. Quantity of water claimed and used is 60 gallons per minute; 95 acre feet per year.

5. Purpose or Purposes for which water is used IRRIGATION

(Domestic, irrigation, municipal, manufacturing, industrial, etc.)

6. Description of Well: Depth 55 feet. Type DRILED

(Dug or drilled)

diameter _____ inches. Elevation of ground at well site 230 ft. feet, mean sea level.

(As near as known)

Depth to water table 40 feet.

7. Capacity of Well: 200 g.p.m. with 11 ft. feet drawdown.

_____ g.p.m. with _____ feet drawdown.

Date of test OCT 25 - 1950

If Flowing Well: Measured discharge _____ g.p.m. on _____

(Date)


Shut-in pressure at ground surface _____ lbs. per sq. in. on _____

(Date)

Water is controlled by _____

(Cap, valve, etc.)

Township 11.5 Range 4. W, W.M.
North

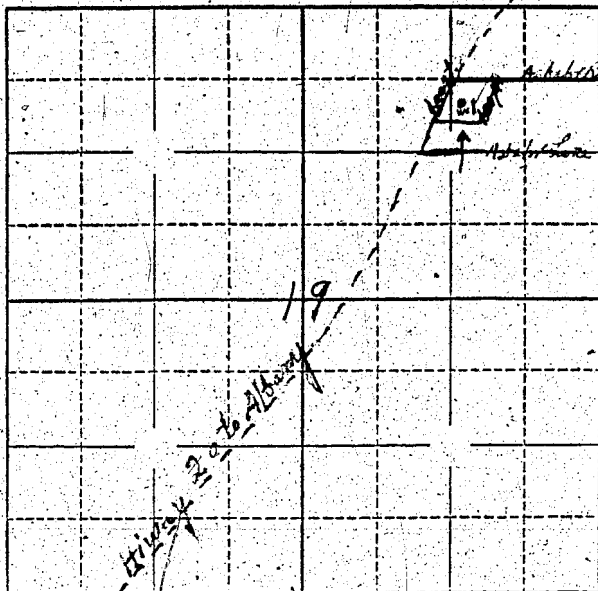

Locate well and acreage of irrigated land on plat.
Scale: 2" = 1 Mile

STATE OF OREGON

County of Benton

I, Emil B. Schlittmeier, being first duly sworn, do hereby certify that I have read the foregoing Registration Statement and that all of the items therein contained are true to the best of my knowledge and belief.

Emil B. Schlittmeier
(Signature of Registrant)

Subscribed and sworn to before me this 24th day of JANUARY, 1956

My commission expires 8-24-57

Ed B. Lewis
(Notary Public)

(SEAL)

CERTIFICATE OF REGISTRATION

STATE OF OREGON

County of Marion } ss.

This is to certify that the foregoing Registration Statement was received in the office of the State Engineer on the 25th day of January, 1956, at 8:00 o'clock A. M. and has been duly recorded in said office in Book No. 1 of Registration Statements on page 74

Construction ^{is} shall be completed by _____, 19____, and the water ^{is} completely applied to beneficial use by _____, 19____.

Witness my hand this 24th day of February, 1956.

Lewis A. Stanley
(State Engineer)

By _____
(Deputy)