

Registration Statement

REGISTRATION NO. G.R. 887CERTIFICATE NO. OR-861

OF CLAIMANT OF RIGHT TO APPROPRIATE GROUND WATER

(Under Chapter 708, Oregon Laws 1955.)

TO THE STATE ENGINEER OF OREGON:

I, Lena May Carpenterof 2285 Carpenter Pl. Salem, Oregon, County of PolkState of Oregon do hereby make application for a certificate of registration as evidence of a right to appropriate ground water.1. Source from which water is withdrawn is Perennial #2
(Flowing well, pump well, infiltration trench, or tunnel)2. Location is: 3 miles northwest of Salem
(Approximate distance and direction from nearest city or town)

and is more particularly described as follows:

(a) 1700 feet east and 1420 feet south from NW corner Section 15
(Give distance and bearing to corner of section or other local subdivision)being within SE 1/4 of NW 1/4 of Sec. 15 Twp. 7S Rge. 3 W
(Smallest legal subdivision) (N. or S.) (E. or W.)

or (b), within limits of recorded platted property, town or city:

Lot _____ Block _____ of _____
(Name of plat or addition)_____ County of _____
(If within city or town, give name)3. Construction Work was begun on 1954; was completed on 1954
(Date)and the ground water claimed was first used for the purposes set out below on 1954
(Date)since which time the water has been used intermittently during season
(Continuously or Interseasonally)From 1954 to Oct. 1957
(Date) (Date)4. Quantity of water claimed and used is 400 gallons per minute; _____ acre
feet per year.5. Purpose or Purposes for which water is used Irrigation
(Domestic, irrigation, municipal, manufacturing, industrial, etc.)6. Description of Well: Depth 35 feet. Type drilled
(Dug or drilled)diameter 10 inches. Elevation of ground at well site 175 feet, mean sea level.
(As near as known)Depth to water table 20 feet.7. Capacity of Well: 4500 g.p.m. with 2 feet drawdown.

_____ g.p.m. with _____ feet drawdown.

Date of test Aug. 1954


If Flowing Well: _____ g.p.m. on _____ (Date)

Shut-in pressure _____ surface _____ lbs. per sq. in. on _____ (Date)

Water is controlled _____
(Cap, valve, etc.)

See Map in file GR-885

Township 75 Range 3W W.M.
North

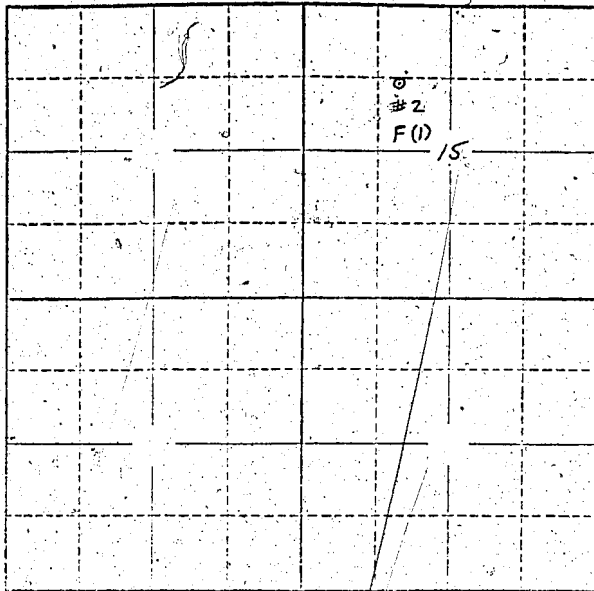

Locate well and acreage of irrigated land on plat.
Scale: 2" = 1 Mile

STATE OF OREGON

County of Marion ss.

I, Lena May Carpenter, being first duly sworn, do hereby certify that I have read the foregoing Registration Statement and that all of the items therein contained are true to the best of my knowledge and belief.

Lena May Carpenter
(Signature of Registrant)

Subscribed and sworn to before me this 15th day of January, 1958.

My commission expires June 12th, 1961

Wm. S. Bartholomew
(Notary Public)

(SEAL)

CERTIFICATE OF REGISTRATION

STATE OF OREGON

County of Marion } ss.

This is to certify that the foregoing Registration Statement was received in the office of the State Engineer on the day of 19....., at o'clock M. and has been duly recorded in said office in Book No. 5 of Registration Statements on page 62

Witness my hand this 24 day of April, 1958.

Lena May Carpenter
(State Engineer)

By (Deputy)

GR-885 C