

RECEIVED
JAN 10 1947
STATE ENGINEER
SALES OFFICE

REGISTRATION NO. GR-89
CERTIFICATE NO. GR-85

Registration Statement

OF CLAIMANT OF RIGHT TO APPROPRIATE GROUND WATER

(Under Chapter 708, Oregon Laws 1955.)

TO THE STATE ENGINEER OF OREGON:

I, Leo F. and Beryl G. Michele

of 1130 West 12th Ave., Albany County of Linn

State of Oregon do hereby make application for a certificate of registration as evidence of a right to appropriate ground water.

1. Source from which water is withdrawn is pump wells (2)
(Flowing well, pump well, infiltration trench, or tunnel)

2. Location is: 7 miles west of Jefferson, Oregon
(Approximate distance and direction from nearest city or town)

and is more particularly described as follows:

1. S. 29⁰ W. 30.5 chains from the NE corner S. 12, T. 10 S., R. 1 W.
(a) 2. S. 34⁰ W. 27.5 chains from the NE corner S. 12, T. 10 S., R. 1 W.
(Give distance and bearing to corner of section or other legal subdivision)

being within SE¹ of NE¹ of Sec. 12, Twp. 10 S., Rge. 1 W.
(Smallest legal subdivision) (N. or S.) (E. or W.)

or (b) within limits of recorded platted property, town or city:

in Lot _____, Block _____ of _____
(Name of plat or addition)

County of Linn
(If within city or town, give name)

3. Construction Work was begun on June 1, 1947; was completed on June 3, 1947
(Date) (Date)

and the ground water claimed was first used for the purposes set out below on June 1, 1947
(Date)

since which time the water has been used continuously
(Continuously or intermittently)

from June 1, 1947 to Aug. 15, 1955
(Date) (Date)

4. Quantity of water claimed and used is 2,200 gallons per minute; 2,50 acre feet per year.

5. Purpose or Purposes for which water is used Irrigation

*Domestic, irrigation, municipal, manufacturing, industrial, etc.)

6. Description of Well: Depth 2,23 feet. Type drilled
(Dug or drilled)

diameter 10 inches. Elevation of ground at well site 1,179 feet, mean sea level.
(As near as known)

Depth to water table 2,8 feet.

7. Capacity of Well: 1,400 g.p.m. with 15 feet drawdown.

2,300 g.p.m. with 10 feet drawdown.

Date of test Estimated

If Flowing Well: Measured discharge _____ g.p.m. on _____
(Date)

Shut-in pressure at ground surface _____ lbs. per sq. in. on _____
(Date)

Water is controlled by _____
(Cap, valve, etc.)

8. Casing: (Give diameter, commercial specifications and depth below ground surface of each casing size.)

- 1. 10 inch diameter steel casing from 0 to 29 feet
- 2. 10 inch diameter " " from 0 to 23 1/2 feet
- inch diameter from to feet
- inch diameter from to feet

Describe and show depth of shoe, plug, adapter, liner or other details:

.....

.....

9. Perforated Casings or Screens:

- 1. 12" X 1/4" slits staggered around pipe from 20 to 29
(Number per foot and size of perforations, or describe screen)
- 2. (Same) from 11 1/2 to 23 1/2
- from to
- from to

10. Log of Well: (Describe each stratum or formation clearly, indicate if water bearing, and give thickness and depth as indicated.)

MATERIAL	Thickness (Feet)	Depth to Bottom (Feet)
1. Top soil	4	4
Sand	4	8
Gravel	21	29
2. Top soil	2	2
Sand	12	14
Gravel	9 1/2	23 1/2

If log of well is not available, give name and address of driller:

11. Infiltration Trench: Covered or open

Dimensions: Length ft. Minimum depth ft. Maximum depth ft.

Bottom width ft. Discharge g.p.m. Date of test

12. Tunnel: Type of lining

Dimensions: (length, course, and cross sectional size)

Position of water bearing stratum with reference to portal of tunnel

Log of tunnel: (Preceding table for log of well may be used, if desired. Give footage from portal and character of materials, as pertinent.)

13. Pumping Equipment:

(a) Pump 1. 3" Fairbanks Morse Centrifugal 1. 450
 2. 2 1/2" Allis Chalmers Capacity 2. 375 g.p.m.


(b) Motor 1. 15 H.P. electric (Make, type and size)
 2. 15 H.P. electric (Type and horsepower)

14. Location of area irrigated or to be irrigated, or place of use if for purposes other than irrigation.

Township North or South	Range E. or W. of Willamette Meridian	Section	Forty-acre Tract	Number Acres To Be Irrigated	Date of Reclamation
10 S	4 W	12	SE 1/4 of NE 1/4	30.0	6/4/47 Prior to 1900
10 S	4 W	12	SW 1/4 of NE 1/4	13.8	" "
10 S	4 W	12	SE 1/4 of NE 1/4	10.0	" "
10 S	4 W	12	SW 1/4 of NE 1/4	4.6	" "
10 S	4 W	12	NE 1/4 of NE 1/4	12.0	" "
10 S	4 W	12	NW 1/4 of NE 1/4	5.25 75.65	" "
* 10S	3W	7	SW 1/4 of NW 1/4	3.2	" "
10S	4W	12	SE 1/4 of NE 1/4	28.3	" "
10S	4W	12	SW 1/4 of NE 1/4	8.5	" "
				40.0	
* 2 10S	3W	7	NW 1/4 of NW 1/4	3.2	" "
10S	4W	12	NE 1/4 of NE 1/4	28.3	" "
10S	4W	12	NW 1/4 of NE 1/4	8.5	" "
				40.0	

15. If the ground water supply is supplemental to an existing water supply, identification of any application for a permit, permit, certificate or adjudicated right to appropriate water made or held by the registrant.

Township 10S Range 4W W.M.
North

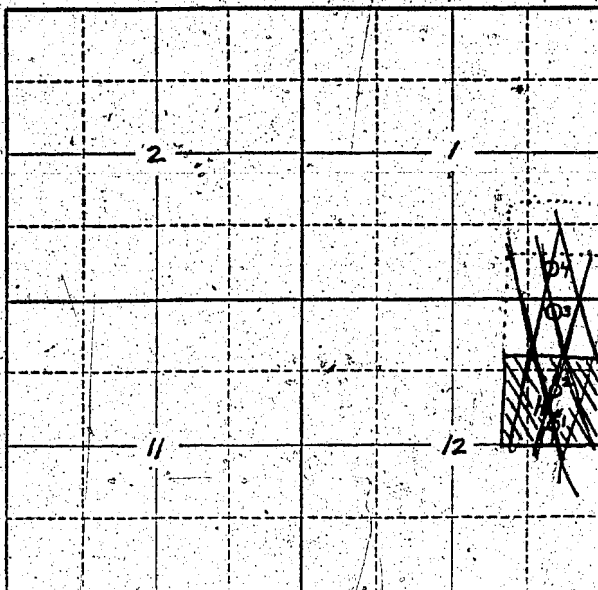

See Map
in G-220

Locate well and acreage of irrigated land on plat.
Scale: 2" = 1 Mile

STATE OF OREGON

County of Linn

ss.

I, Leo F. and Beryl G. Michele, being first duly sworn, do hereby certify that I have read the foregoing Registration Statement and that all of the items therein contained are true to the best of my knowledge and belief.

Leo F. Michele
Beryl G. Michele (Signature of Registrant)

Subscribed and sworn to before me this 19th day of January, 1956.

My commission expires Sept 3, 1957

Ann Landwehr
(Notary Public)

(SEAL)

CERTIFICATE OF REGISTRATION

STATE OF OREGON

County of Marion

ss.

This is to certify that the foregoing Registration Statement was received in the office of the State Engineer on the 25th day of January, 1956, at 1:00 o'clock A.M. and has been duly recorded in said office in Book No. 1 of Registration Statements on page GR-85C.

Construction shall ^{is} be completed by _____, 1956, and the water ^{is} completely applied to beneficial use by _____, 1956.

Witness my hand this 12th day of April, 1956.

Lewis A. Stanley
(State Engineer)

By _____
(Deputy)