

# Registration Statement

## OF CLAIMANT OF RIGHT TO APPROPRIATE GROUND WATER

TO THE STATE ENGINEER OF OREGON:

I, SE Cox & Mabel Cox  
 of Route 3, Box 211, Medford County of Jackson  
(Mailing address)  
 State of Oregon, do hereby make application for a certificate of registration as evidence  
 of a right to appropriate ground water.

1. Source from which water is withdrawn is SUMP  
(Flowing well, pump well, infiltration trench, or tunnel)

2. Location is: ONE-HALF MILE EAST OF PHOENIX CREEK  
(Approximate distance and direction from nearest city or town)

and is more particularly described as follows:

(a) 2700 ft. South & 1200 ft. West from the NE Cor. D.L.C #42  
(Give distance and bearing to corner of section or other legal subdivision)

being within SW 1/4 NE 1/4 SW 1/4 of Sec. 16, Twp. 33 S, Rge. 11 W  
(Smallest legal subdivision) (N. or S.) (E. or W.)

or (b) within limits of recorded platted property, town or city:

in Lot \_\_\_\_\_ Block \_\_\_\_\_ of \_\_\_\_\_  
(Name of plat or addition)

County of \_\_\_\_\_  
(If within city or town, give name)

3. Construction Work was begun on Nov 16, 1935; was completed on Nov 15, 1935  
(Date) (Date)

and the ground water claimed was first used for the purposes set out below on Nov 25, 1935  
(Date)

since which time the water has been used INTERMITTENTLY  
(Continuously or intermittently)

from 7-25-35 to 10-1-37  
(Date) (Date)

4. Quantity of water claimed and used is 376 gallons per minute; \_\_\_\_\_ acre  
 feet per year.

5. Purpose or Purposes for which water is used Domestic use of ground water  
(Domestic, irrigation, municipal, manufacturing, industrial, etc.)

6. Description of Well: Depth 10 feet. Type: D  
(Dug or drilled)

diameter 1.75 inches. Elevation of ground at well site 1490 feet, mean sea level.  
(As near as known)

Depth to water table 3.5 feet.

7. Capacity of Well: 376 g.p.m. with 20 feet drawdown.

\_\_\_\_\_ g.p.m. with \_\_\_\_\_ feet drawdown.

Date of test Nov 16, 1935

If Flowing Well: Measured discharge \_\_\_\_\_ g.p.m. on \_\_\_\_\_  
(Date)

Shut-in pressure at ground surface \_\_\_\_\_ lbs. per sq. in. on \_\_\_\_\_  
(Date)

Water is controlled by \_\_\_\_\_  
(Cap, valve, etc.)






385

1W

Township ..... Range ..... W.M.  
North

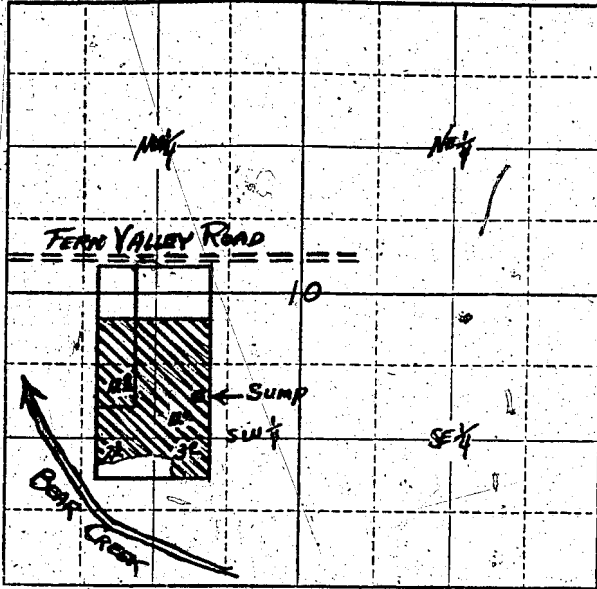

Locate well and acreage of irrigated land on plat.

Scale:  $\frac{1}{4}$  - 1 Mile

STATE OF OREGON


I, S. E. C. & M. J. S. Co., being first duly sworn, do hereby certify that I have read the foregoing Registration Statement and that all of the items therein contained are true to the best of my knowledge and belief.

[Signature]  
(Signature of Registrant)

Subscribed and sworn to before me this 19<sup>th</sup> day of April, 1958.

My commission expires APRIL 1, 1953

[Signature]  
(Notary Public)

(SEAL)

**CERTIFICATE OF REGISTRATION**

STATE OF OREGON } ss.  
County of Marion

This is to certify that the foregoing Registration Statement was received in the office of the State Engineer on the 19<sup>th</sup> day of April, 1958, at 5 o'clock P.M. and has been duly recorded in said office in Book No. 5 of Registration Statements on page 667.

Witness my hand this 24 day of April, 1958

[Signature]  
(State Engineer)

By .....  
(Deputy)

GR - 867 C