

Registration Statement

OF CLAIMANT OF RIGHT TO APPROPRIATE GROUND WATER

TO THE STATE ENGINEER OF OREGON:

I, ARMAND JOHN DE ROSSET JR

of BEAVERTON, MT. HOOD ROAD County of WASHINGTON

State of OREGON, do hereby make application for a certificate of registration as evidence of a right to appropriate ground water.

- 1. Source from which water is withdrawn is PUMP WELL
(Flowing well, pump well, infiltration trench, or tunnel)
- 2. Location is: 3 MI. SW BEAVERTON
(Approximate distance and direction from nearest city or town)

and is more particularly described as follows:

(a) 120' N - 120' E OF 1/2 CORNER ON THE SOUTH LINE OF
(Give distance and bearing to corner of section or other legal subdivision)

being within SW 1/4 OF THE SE 1/4 of Sec. 29, Twp. 15, Rge. 1
(Smallest legal subdivision) (N. or S.) (E. or W.)

or (b) within limits of recorded platted property, town or city:

in Lot _____, Block _____ of _____
(Name of plat or addition)

County of _____
(If within city or town, give name)

3. Construction Work was begun on 5-11-75; was completed on 5-11-75
(Date) (Date)

and the ground water claimed was first used for the purposes set out below on _____
(Date)

since which time the water has been used CONTINUOUSLY
(Continuously or intermittently)

from 1-1-75 to 7-1-11-75
(Date) (Date)

4. Quantity of water claimed and used is _____ gallons per minute; _____ acre feet per year.

5. Purpose or Purposes for which water is used DOMESTIC & IRRIGATION
(Domestic, irrigation, municipal, manufacturing, industrial, etc.)

6. Description of Well: Depth 230 feet. Type DRILLED
(Dug or drilled)

diameter _____ inches. Elevation of ground at well site 230 feet, mean sea level.
(As near as known)

Depth to water table _____ feet.

7. Capacity of Well: _____ g.p.m. with _____ feet drawdown.

_____ g.p.m. with _____ feet drawdown.

Date of test _____

If Flowing Well: Measured discharge _____ g.p.m. on _____
(Date)

Shut-in pressure at ground surface _____ lbs. per sq. in. on _____
(Date)

Water is controlled by _____
(Cap, valve, etc.)

8. Casing: (Give diameter, commercial specifications and depth below ground surface of each casing size.)

6 inch diameter from to feet
..... inch diameter from to feet
..... inch diameter from to feet
..... inch diameter from to feet

Describe and show depth of shoe, plug, adapter, liner or other details: DETAILS UNKNOWN
.....
.....

9. Perforated Casings or Screens:

UNKNOWN from to
(Number per foot and size of perforations, or describe screen)
..... from to
..... from to
..... from to

10. Log of Well: (Describe each stratum or formation clearly, indicate if water bearing, and give thickness and depth as indicated.)

MATERIAL	Thickness (Feet)	Depth to Bottom (Feet)
<u>UNKNOWN</u>		<u>0</u>

If log of well is not available, give name and address of driller. ZIMMERMAN

LEST WASHINGTON COUNTY - PRESENT UNDEVELOPED

11. Infiltration Trench: Covered or open

Dimensions: Length ft. Minimum depth ft. Maximum depth ft.

Bottom width ft. Discharge g.p.m. Date of test

12. Tunnel: Type of lining

Dimensions:
(Length, course, and cross sectional size)

Position of water bearing stratum with reference to portal of tunnel

Log of tunnel: (Preceding table for log of well may be used, if desired. Give footage from portal and character of materials, as pertinent.)

13. Pumping Equipment:

(a) Pump REDUCTION IN MECHANICAL EFFICIENCY Capacity g.p.m.
(Make, type and size)


(b) Motor REPLACEMENT PUMPED IN USAK TYPE
Set at 125 feet.
(Type and horsepower)

14. Location of area irrigated or to be irrigated, or place of use if for purposes other than irrigation.

Township North or South	Range E. or W. of Willamette Meridian	Section	Forty-acre Tract	Number Acres To Be Irrigated	Date of Reclamation
<u>21N</u>	<u>1W</u>	<u>26</u>	<u>SW 1/4 of NE 1/4</u>	<u>North 15</u>	<u>1948</u>

15. If the ground water supply is supplemental to an existing water supply, identification of any application for a permit, permit, certificate or adjudicated right to appropriate water made or held by the registrant.

Township 15 Range 11 W.M.
North

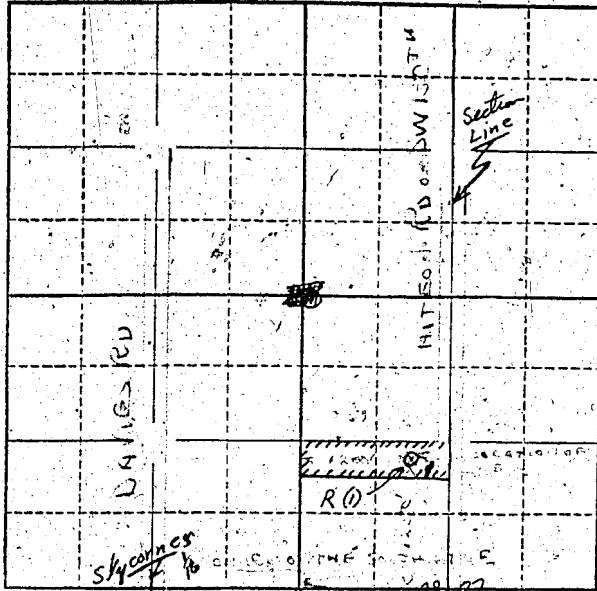

Locate well and acreage of irrigated land on plat.

Scale: $\frac{1}{2}$ " = 1 Mile

STATE OF OREGON

County of Marion

I, Clarence J. [Signature] being first duly sworn, do hereby certify that I have read the foregoing Registration Statement and that all of the items therein contained are true to the best of my knowledge and belief.

Clarence J. [Signature]
(Signature of Registrant)

Subscribed and sworn to before me this 17th day of January, 1958

My commission expires 12 June 1961

Wm. S. Bartholomew
(Notary Public)

(SEAL)

CERTIFICATE OF REGISTRATION

STATE OF OREGON

County of Marion

This is to certify that the foregoing Registration Statement was received in the office of the State Engineer on the 17 day of January, 1958, at 8:00 o'clock A.M. and has been duly recorded in said office in Book No. 2 of Registration Statements on page 269

Witness my hand this 24 day of April, 1958

Lewis A. [Signature]
(State Engineer)

By _____
(Deputy)

GR - 869 C