Registration No. GR- 897

Certificate No. GR - 872

Registration Statement

OF CLAIMANT OF RIGHT TO APPROPRIATE GROUND WATER

TO THE STATE ENGINEER OF OREGON:

I, P. W. and Florence E. Drushella,

of Rt. 3, Scio (Mailing address) County of Linn

State of Oregon, do hereby make application for a certificate of registration as evidence of a right to appropriate ground water.

1. **Source** from which water is withdrawn is pump well #1 (Flowing well, pump well, infiltration trench, or tunnel)

2. **Location** is: ; (Approximate distance and direction from nearest city or town)

and is more particularly described as follows:

(a) N. 22° W. 13 chains from SE corner of S. 33, T. 10 S, R. 2 W. (Give distance and bearing to corner of section or other legal subdivision)

being within SE¼ of SE¼ (Smallest legal subdivision) of Sec. 33, Twp. 10 S (N. or S.), Rge. 2 W (E. or W.)

or (b) within limits of recorded platted property, town or city:

in Lot ....., Block ..... of ..... (Name of plat or addition)

..... (If within city or town, give name) County of Linn

3. **Construction Work** was begun on Nov. 1951 (Date); was completed on Nov. 1951 (Date)

and the ground water claimed was first used for the purposes set out below on June 1952 (Date),

since which time the water has been used continuously (Continuously or intermittently)

from June 1952 (Date) to present time (Date)

4. **Quantity** of water claimed and used is 500 gallons per minute; 225 acre feet per year.

5. **Purpose or Purposes** for which water is used Irrigation

(Domestic, irrigation, municipal, manufacturing, industrial, etc.)

6. **Description of Well:** Depth 33 feet. Type Drilled (Dug or drilled)

diameter 10 inches. Elevation of ground at well site ~~260~~ 264 (As near as known) feet, mean sea level.

Depth to water table 13 feet.

7. **Capacity of Well:** 600 g.p.m. with 20 feet drawdown.

..... g.p.m. with ..... feet drawdown.

Date of test Estimated - not tested

If Flowing Well: Measured discharge ..... g.p.m. on ..... (Date)

Shut-in pressure at ground surface ..... lbs. per sq. in. on ..... (Date)

Water is controlled by ..... (Cap, valve, etc.)

4M—4-57

8. **Casing:** (Give diameter, commercial specifications and depth below ground surface of each casing size.)

10 inch diameter steel casing from 0 to 33 feet

inch diameter from to feet

inch diameter from to feet

inch diameter from to feet

Describe and show depth of shoe, plug, adapt[illegible]er or other details:

9. **Perforated Casings or Screens:**

Slot perforations from 25 to 33
(Number per foot and size of perforations, or describe screen)

from to

from to

from to

10. **Log of Well:** (Describe each stratum or formation clearly, indicate if water bearing, and give thickness and depth as indicated.)

MATERIAL	Thickness (Feet)	Depth to Bottom (Feet)
Not available		

GR - 872 A

If log of well is not available, give name and address of driller. Nicholas Klaus, Route 1, Albany, Oregon

11. **Infiltration Trench:** Covered or open .....

Dimensions: Length ..... ft. Minimum depth ..... ft. Maximum depth ..... ft.

Bottom width ..... ft. Discharge ..... g.p.m. Date of test .....

12. **Tunnel:** Type of lining .....

Dimensions: .....
(Length, course, and cross sectional size)

Position of water bearing stratum with reference to portal of tunnel .....

Log of tunnel: (Preceding table for log of well may be used, if desired. Give footage from portal and character of materials, as pertinent.)

13. **Pumping Equipment:**

(a) Pump 3" centrifugal (Make, type and size) Capacity 500 g.p.m.

(b) Motor 20 H. P. electric (Type and horsepower)

14. Location of area irrigated or to be irrigated, or place of use if for purposes other than irrigation.

Township North or South	Range E. or W. of Willamette Meridian	Section	Forty-acre Tract	Number Acres To Be Irrigated	Date of Reclamation
10 S	2 W	33	SE¼ of SE¼	37.0	June 1952
10 S	2 W	33	SW¼ of SE¼	3.0	" "
11 S	2 W	4	NE¼ of NE¼	36.2	" "
11 S	2 W	4	SE¼ of NE¼	13.8	" "
				90.0	

15. If the ground water supply is supplemental to an existing water supply, identification of any application for a permit, permit, certificate or adjudicated right to appropriate water made or held by the registrant.

GR-872 B

Township 10 & 11 S Range 2 W, W.M.

North

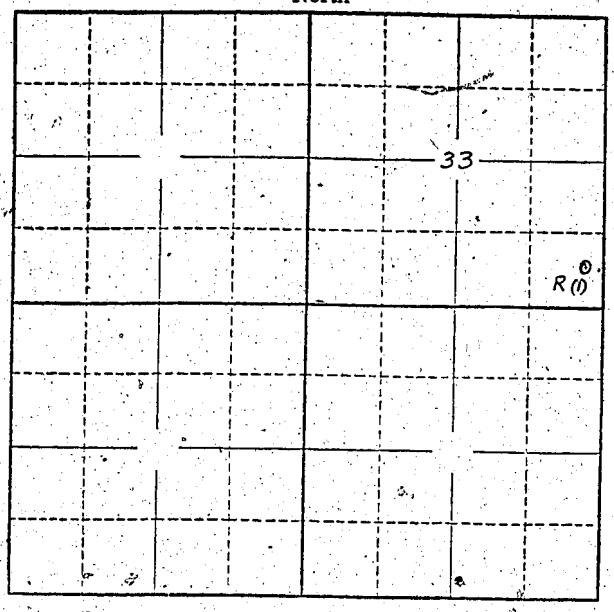

Locate well and acreage of irrigated land on plat.

Scale: 2" = 1 Mile

STATE OF OREGON
County of LINN } ss.

I, P. W. and Florence E. Drushella, being first duly sworn, do hereby certify that I have read the foregoing Registration Statement and that all of the items therein contained are true to the best of my knowledge and belief.

P. W. Drushella

(Signature of Registrant)

Subscribed and sworn to before me this 14 day of Jan, 1958

My commission expires

F. E. Drushella
(Notary Public)

(SEAL)

Comm exp Mar 19-1960

CERTIFICATE OF REGISTRATION

STATE OF OREGON
County of Marion } ss.

This is to certify that the foregoing Registration Statement was received in the office of the State Engineer on the 17th day of January, 1958, at 8:00 o'clock A M. and has been duly recorded in said office in Book No. 5 of Registration Statements on page 872

Witness my hand this 24 day of April, 1958

Lewis A. Stone
(State Engineer)

By
(Deputy)

GR - 872 C