

Registration Statement

OF CLAIMANT OF RIGHT TO APPROPRIATE GROUND WATER

TO THE STATE ENGINEER OF OREGON:

I, Lloyd J. Fortner

of Route 1, Box 249, Albany, Oregon County of Wasco

State of Oregon, do hereby make application for a certificate of registration as evidence of a right to appropriate ground water.

1. Source from which water is withdrawn is Pump well (Flowing well, pump well, infiltration trench, or tunnel)

2. Location is: 8 miles NE of Albany, Oregon (Approximate distance and direction from nearest city or town)

and is more particularly described as follows:

(a) S. 4 3/4 W. 23.5 Chains from SW corner of S16 T2 N35 E33 (Give distance and bearing to corner of section or other legal subdivision)

being within NE 1/4 SW 1/4 of Sec. 30, Twp. 12 N., Rge. 2 E. (Smallest legal subdivision) (N. or S.) (E. or W.)

or (b) within limits of recorded platted property, town or city:

in Lot, Block of (Name of plat or addition)

County of Wasco (If within city or town, give name)

3. Construction Work was begun on April 10, 1949 (Date); was completed on (Date)

and the ground water claimed was first used for the purposes set out below on (Date)

since which time the water has been used Continuously (Continuously or intermittently)

from June 1, 1949 (Date) to present (Date)

4. Quantity of water claimed and used is 3000 gallons per minute; 110.5 acre feet per year.

5. Purpose or Purposes for which water is used Irrigation (Domestic, irrigation, municipal, manufacturing, industrial, etc.)

6. Description of Well: Depth feet. Type Infiltration (Dug or drilled)

diameter inches. Elevation of ground at well site feet, mean sea level. (As near as known)

Depth to water table 10 feet.

7. Capacity of Well: g.p.m. with feet drawdown.

g.p.m. with feet drawdown.

Date of test

If Flowing Well: Measured discharge g.p.m. on (Date)

Shut-in pressure at ground surface lbs. per sq. in. on (Date)

Water is controlled by (Cap, valve, etc.)

If log of well is not available, give name and address of driller. Nicholas Klaus, Route 4, Albany, Ore.

11. Infiltration Trench: Covered or open

Dimensions: Length ft. Minimum depth ft. Maximum depth ft.

Bottom width ft. Discharge g.p.m. Date of test

12. Tunnel: Type of lining

Dimensions:
(Length, course, and cross sectional size)

Position of water bearing stratum with reference to portal of tunnel

Log of tunnel: (Preceding table for log of well may be used, if desired. Give footage from portal and character of materials, as pertinent.)

13. Pumping Equipment:

(a) Pump 3" Centrifugal Capacity 400 g.p.m.
(Make, type and size)

(b) Motor 15 H.P. Electric
(Type and horsepower)

14. Location of area irrigated or to be irrigated, or place of use if for purposes other than irrigation.


Township North or South	Range E. or W. of Willamette Meridian	Section	Forty-acre Tract	Number Acres To Be Irrigated	Date of Reclamation
10S.	2E.	30	SE $\frac{1}{4}$ of NE $\frac{1}{4}$	6.3	June, 1929
10S.	2E.	30	SE $\frac{1}{4}$ of NE $\frac{1}{4}$	5.8	" "
10E.	2W.	30	NE $\frac{1}{4}$ of SE $\frac{1}{4}$	22.5	" "
10E.	2W.	30	SE $\frac{1}{4}$ of SE $\frac{1}{4}$	4.2	" "
10S.	2E.	30	SW $\frac{1}{4}$ of SE $\frac{1}{4}$	3.6	" "
				42.4	

159-525

beginning at a point where the center line of the county road intersects the western boundary line of the D.L.C. of William Earl and wife, (not 152), and claim of A. F. 10 S., 2 E. of the Will. Mer. in Clatsop County, Oregon; and running thence N. 19° 20' E. along the western boundary line of said D.L.C. 55.50 chains to the northwestern corner of said D.L.C.; thence S. 77° 22' E. along the North boundary line of said D.L.C. 12.84 chains; thence S. 11° 20' W. parallel with and 12.84 chains distant from (measuring at right angles), the west boundary line of said D.L.C. 36.00 chains to the center of said county road; thence S. 21° 30' W. along the center of said county road 19.80 chains to the place of beginning.

15. If the ground water supply is supplemental to an existing water supply, identification of any application for a permit, permit, certificate or adjudicated right to appropriate water made or held by the registrant.

Township 10 S. Range 2 W. W.M.
North

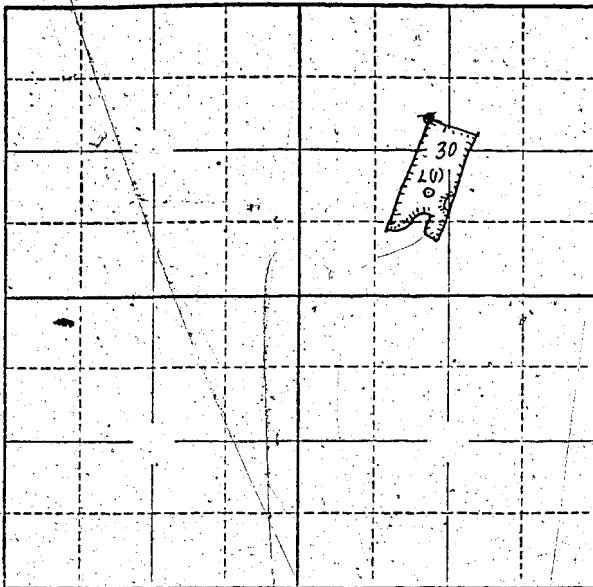

Locate well and acreage of irrigated land on plat.
Scale: 2" = 1 Mile

STATE OF OREGON

County of Linn

ss.

I, [Signature], being first duly sworn, do hereby certify that I have read the foregoing Registration Statement and that all of the items therein contained are true to the best of my knowledge and belief.

[Signature]
(Signature of Registrant)

Subscribed and sworn to before me this 24 day of April, 1958.

My commission expires April 21, 1959

(Notary Public)

(SEAL)

CERTIFICATE OF REGISTRATION

STATE OF OREGON

County of Marion

ss.

This is to certify that the foregoing Registration Statement was received in the office of the State Engineer on the 24 day of April, 1958, at 10 o'clock A.M. and has been duly recorded in said office in Book No. 5 of Registration Statements on page 875.

Witness my hand this 24 day of April, 1958.

[Signature]
(State Engineer)

By [Signature]
(Deputy)

GR 875