

RECEIVED

JAN 20 1958

STATE ENGINEER
SALEM, OREGON

Registration No. GR- 803

Certificate No. GR- 878

Registration Statement

OF CLAIMANT OF RIGHT TO APPROPRIATE GROUND WATER

TO THE STATE ENGINEER OF OREGON:

I, Lloyd J. Porter

of Route 1, Box 269, Albany, Oregon
(Mailing address)

County of Linn

State of Oregon

do hereby make application for a certificate of registration as evidence of a right to appropriate ground water.

1. Source from which water is withdrawn is Pump well
(Flowing well, pump well, infiltration trench, or tunnel)

2. Location is: 6 miles NE of Albany, Oregon
(Approximate distance and direction from nearest city or town)

and is more particularly described as follows:

(a) S. 56° 20' N., 20.75 Chains from NE corner of T10 N., R. 21 W.
(Give distance and bearing to corner of section or other legal subdivision)

being within NE 1/4 of NE 1/4 of Sec. 5, Twp. 11 S. Rge. 21 W.
(Smallest legal subdivision) (N. or S.) (E. or W.)

or (b) within limits of recorded platted property, town or city:

in Lot _____ Block _____ of _____
(Name of plat or addition)

County of Linn
(If within city or town, give name)

3. Construction Work was begun on April, 1949; was completed on April 1949
(Date) (Date)

and the ground water claimed was first used for the purposes set out below on June, 1949
(Date)

since which time the water has been used Continuously
(Continuously or intermittently)

from June, 1949 to present time
(Date) (Date)

4. Quantity of water claimed and used is 400 gallons per minute; 75 acre feet per year.

5. Purpose or Purpose for which water is used Irrigation
(Domestic, irrigation, municipal, manufacturing, industrial, etc.)

6. Description of Well: Depth 28 feet. Type Drilled
(Dug or drilled)

diameter 8 inches. Elevation of ground at well site 255 feet, mean sea level.
(As near as known)

Depth to water table 16 feet.

7. Capacity of Well: 300 g.p.m. with 5 feet drawdown.

_____ g.p.m. with _____ feet drawdown.

Date of test Estimated - not tested

If Flowing Well: Measured discharge _____ g.p.m. on _____
(Date)

Shut-in pressure at ground surface _____ lbs. per sq. in. on _____
(Date)

Water is controlled by _____
(Cap, valve, etc.)

8. **Casing:** (Give diameter, commercial specifications and depth below ground surface of each casing size.)

8 inch diameter Steel casing from 0 to 28 feet
inch diameter from to feet
inch diameter from to feet
inch diameter from to feet

Describe and show depth of shoe, plug, adapter, liner or other details:
.....
.....

9. **Perforated Casings or Screens:**

Slot perforations from 20 to 28
(Number per foot and size of perforations, or describe screen)
from to
from to
from to

10. **Log of Well:** (Describe each stratum or formation clearly, indicate if water bearing, and give thickness and depth as indicated.)

MATERIAL	Thickness (Feet)	Depth to Bottom (Feet)
Not available		

If log of well is not available, give name and address of driller. Unknown.....

11. Infiltration Trench: Covered or open

Dimensions: Length ft. Minimum depth ft. Maximum depth ft.

Bottom width ft. Discharge g.p.m. Date of test

12. Tunnel: Type of lining

Dimensions: (Length, course, and cross sectional size)

Position of water bearing stratum with reference to portal of tunnel

Log of tunnel: (Preceding table for log of well may be used, if desired. Give footage from portal and character of materials, as pertinent.)

13. Pumping Equipment:

(a) Pump 3" Centrifugal Capacity 750 g.p.m.
(Make, type and size)

(b) Motor 15 H.P. Electric
(Type and horsepower)


14. Location of area irrigated or to be irrigated, or place of use if for purposes other than irrigation.

Township North or South	Range E. or W. of Willamette Meridian	Section	Forty-acre Tract	Number Acres To Be Irrigated	Date of Reclamation
10S.	2W	32	SE $\frac{1}{4}$ of SE $\frac{1}{4}$	0.3	June 1945
10S	2W	32	SW $\frac{1}{4}$ of SE $\frac{1}{4}$	2.0	" "
11S	2W	5	NE $\frac{1}{4}$ of T $\frac{1}{4}$	0.1	" "
11S	2W	5	SW $\frac{1}{4}$ of SE $\frac{1}{4}$	22.8	" "
11S	2W	5	SW $\frac{1}{4}$ of NE $\frac{1}{4}$	4.8	" "
				30.0	

15. If the ground water supply is supplemental to an existing water supply, identification of any application for a permit, permit, certificate or adjudicated right to appropriate water made or held by the registrant.

Township 10 & 11 S Range 2 W, W.M.

North

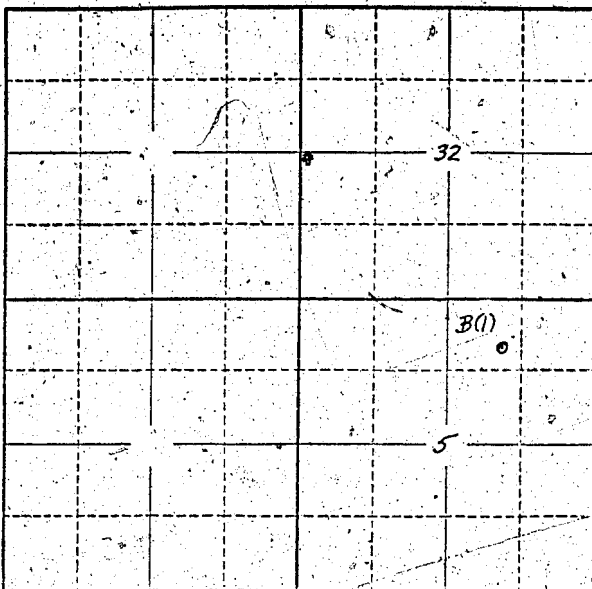

See Map in folder

Locate well and acreage of irrigated land on plat.

Scale: 2" = 1 Mile

STATE OF OREGON

County of Linn

ss.

I, Lloyd J. Porter, being first duly sworn, do hereby certify that I have read the foregoing Registration Statement and that all of the items therein contained are true to the best of my knowledge and belief.

Lloyd J. Porter
(Signature of Registrant)

Subscribed and sworn to before me this 11th day of April, 1958

My commission expires MY COMMISSION EXPIRES DEC. 4, 1958

(Notary Public)

(SEAL)

CERTIFICATE OF REGISTRATION

STATE OF OREGON

County of Marion

ss.

This is to certify that the foregoing Registration Statement was received in the office of the State Engineer on the 6th day of April, 1958, at 10:00 o'clock A.M. and has been duly recorded in said office in Book No. 5 of Registration Statements on page 878

Witness my hand this 24th day of April, 1958

Lewis A. Stanley
(State Engineer)

By _____ (Deputy)

GR - 873 C