

# Registration Statement

## OF CLAIMANT OF RIGHT TO APPROPRIATE GROUND WATER

(Under Chapter 708, Oregon Laws 1955.)

TO THE STATE ENGINEER OF OREGON:

I, Lave Schleg  
of 1385 Cedar Lake Rd County of Marion

State of Oregon, do hereby make application for a certificate of registration as evidence of a right to appropriate ground water.

1. Source from which water is withdrawn is Spring #1  
(Flowing well, pump well, infiltration trench, or tunnel)

2. Location is: 7 mi north of Salem, Oregon  
(Approximate distance and direction from nearest city or town)

and is more particularly described as follows:  
1200 feet west and 200 feet south from east 1/4 corner.  
(a) 40 ft from N.W. corner  
(Give distance and bearing to corner of section or other legal subdivision)

being within NE 1/4 of SE 1/4 of Sec. 23, Twp. 4 South, Rge. 3 West  
(Smallest legal subdivision) (N. or S.) (E. or W.)

or (b) within limits of recorded platted property, town or city:

in Lot 6, Block          of           
(Name of plat or addition)

County of           
(If within city or town, give name)

3. Construction Work was begun on 1953; was completed on 7-3-53  
(Date) (Date)

and the ground water claimed was first used for the purposes set out below on June 15, 1953  
(Date)

since which time the water has been used intermittently  
(Continuously or intermittently)

from          to          57  
(Date) (Date)

4. Quantity of water claimed and used is          gallons per minute;          acre feet per year.

5. Purpose or Purposes for which water is used irrigation  
(Domestic, irrigation, municipal, manufacturing, industrial, etc.)

6. Description of Well: Depth 115 feet. Type hand  
(Dug or drilled)

diameter 10 inches. Elevation of ground at well site 185 feet, mean sea level.  
(As near as known)

Depth to water table 54 feet. Airline set to 100 feet.

7. Capacity of Well: 385 g.p.m. with 84 feet drawdown. 210 - 65'  
150 g.p.m. with 59 feet drawdown. 215 - 65'  
390 - 77'

Date of test 2-25-53

If Flowing Well: Measured discharge          g.p.m. on           
(Date)


Shut-in pressure at ground surface          lbs. per sq. in. on           
(Date)

Water is controlled by           
(Cap. valve, etc.)





Township 6 S Range 3 W W.M.  
North

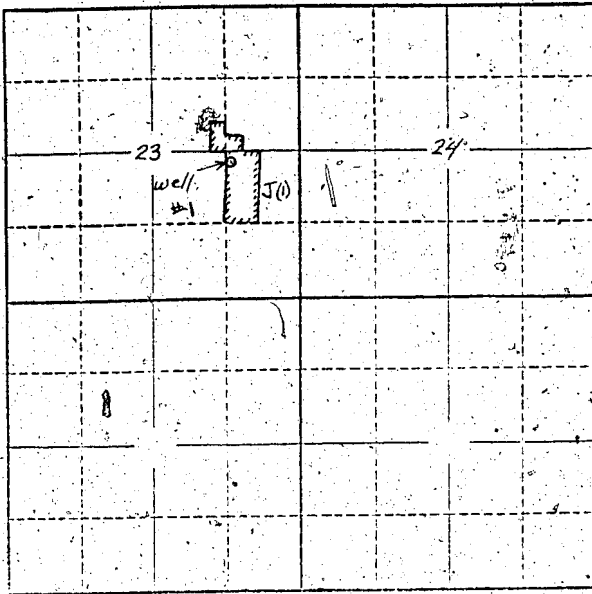

Locate well and acreage of irrigated land on plat.  
Scale: 2" = 1 Mile

STATE OF OREGON }  
County of Marion } ss.

I, \_\_\_\_\_, being first duly sworn, do hereby certify that I have read the foregoing Registration Statement and that all of the items therein contained are true to the best of my knowledge and belief.

Dave Schleg  
(Signature of Registrant)

Subscribed and sworn to before me this 20th day of January, 19 58

My commission expires June 12th, 1961 Wm. S. Bratholme  
(Notary Public)

(SEAL)

**CERTIFICATE OF REGISTRATION**

STATE OF OREGON }  
County of Marion } ss.

This is to certify that the foregoing Registration Statement was received in the office of the State Engineer on the 20 day of January, 19 58, at 8:00 o'clock A. M. and has been duly recorded in said office in Book No. 5 of Registration Statements on page 581

~~Copy of this certificate is to be kept by \_\_\_\_\_ and the original is to be kept by \_\_\_\_\_~~  
~~\_\_\_\_\_~~

Witness my hand this 21 day of April, 19 58

(State Engineer)

By \_\_\_\_\_  
(Deputy)

64-881C