REGISTRATION NO. GR 909
CERTIFICATE NO. GR-883

Registration Statement

OF CLAIMANT OF RIGHT TO APPROPRIATE GROUND WATER

(Under Chapter 708, Oregon Laws 1955.)

TO THE STATE ENGINEER OF OREGON:

I, John A. Moron

of 925 Dearborn Avenue County of Marion

State of Oregon, do hereby make application for a certificate of registration as evidence of a right to appropriate ground water.

1. **Source** from which water is withdrawn is Pump well #1
(Flowing well, pump well, infiltration trench, or tunnel)

2. **Location** is: 1½ Miles SW of Woodburn, Oregon
(Approximate distance and direction from nearest city or town)

and is more particularly described as follows:

(a) 1160 Feet South 200 Feet East from NE Corner of Section 33
(Give distance and bearing to corner of section or other legal subdivision)

being within NW ¼ of NW ¼ of Sec. 24, Twp. 5S (N. or S.), Rge. 2W (E. or W.)
(Smallest legal subdivision)

or (b) within limits of recorded platted property, town or city:

in Lot ....., Block ..... of .....
(Name of plat or addition)

..... County of .....
(If within city or town, give name)

3. **Construction Work** was begun on February 10, 1953 (Date); was completed on February [illegible] (Date)

and the ground water claimed was first used for the purposes set out below on May 27, 1953 (Date)

since which time the water has been used Continuously (Continuously or intermittently)

from May 1953 (Date) to Date (Date)

4. **Quantity** of water claimed and used is 100 gallons per minute; ..... acre feet per year.

5. **Purpose or Purposes** for which water is used Irrigation
(Domestic, irrigation, municipal, manufacturing, industrial, etc.)

6. **Description of Well:** Depth 158 feet. Type Drilled (Dug or drilled)

diameter 8 inches. Elevation of ground at well site 180 (As near as known) feet mean sea level.

Depth to water table 15 feet.

7. **Capacity of Well:** 110 g.p.m. with 50 feet drawdown.

110 g.p.m. with [illegible] feet drawdown.

Date of test February [illegible]

If Flowing Well: Measured discharge ..... g.p.m. on ..... (Date)

Shut-in pressure at ground surface ..... lbs. per sq. in. on ..... (Date)

Water is controlled by ..... (Cap, valve, etc.)

8. **Casing:** (Give diameter, commercial specifications and depth below ground surface of each casing size.)

8 5/8 X .250 inch diameter New black pipe, welded joints from 0 to 136 feet

..... inch diameter ..... from ..... to ..... feet

..... inch diameter ..... from ..... to ..... feet

..... inch diameter ..... from ..... to ..... feet

Describe and show depth of shoe, plug, adapter, liner or other details:

Drive Shoe at 136 feet

9. **Perforated Casings or Screens:**

Perforated with Mills Perforator with 78 cuts from 135' up to 134' from 135 to 134

(Number per foot and size of perforations, or describe screen)

..... from ..... to .....

..... from ..... to .....

..... from ..... to .....

10. **Log of Well:** (Describe each stratum or formation clearly, indicate if water bearing, and give thickness and depth as indicated.)

MATERIAL	Thickness (Feet)	Depth to Bottom (Feet)
Top soil and Silty Sub Soil	6	27
Blue shale	37	72
Fine black sand	72	81
Blue shale	21	102
Black sand & small gravel	10[illegible]	10[illegible]
Black and Brown shale	106	11[illegible]
Water bearing sand and gravel	12[illegible]	13[illegible]

GR- 853 A

If log of well is not available, give name and address of driller. .....

.....

11. **Infiltration Trench:** Covered or open .....

Dimensions; Length ..... ft. Minimum depth ..... ft. Maximum depth ..... ft.

Bottom width ..... ft. Discharge ..... g.p.m. Date of test .....

12. **Tunnel:** Type of lining .....

Dimensions: .....
(Length, course, and cross sectional size)

Position of water bearing stratum with reference to portal of tunnel .....

.....

Log of tunnel: (Preceding table for log of well may be used, if desired. Give footage from portal and character of materials, as pertinent.)

13. **Pumping Equipment:**

(a) Pump Fairbanks Morse Direct Turbine FM 1810 with Watson Flexible Drive (Make, type and size) Capacity 150 - 170 g.p.m.

(b) Motor Oliver Diesel 27 hp (Type and horsepower)

14. Location of area irrigated or to be irrigated, or place of use if for purposes other than irrigation.

Township North or South	Range E. or W. of Willamette Meridian	Section	Forty-acre Tract	Number Acres To Be Irrigated	Date of Reclamation
5 S	[illegible]	[illegible]	[illegible]	16	[illegible]
[illegible]	[illegible]	[illegible]	[illegible]	18	[illegible]
[illegible]	[illegible]	[illegible]	[illegible]	1	[illegible]
[illegible]	[illegible]	[illegible]	[illegible]	16	[illegible]
5 S	[illegible]	[illegible]	[illegible]	[illegible]	[illegible]
[illegible]	[illegible]	[illegible]	[illegible]	[illegible]	[illegible]
[illegible]	[illegible]	[illegible]	[illegible]	72	[illegible]

15. If the ground water supply is supplemental to an existing water supply, identification of any application for a permit, permit, certificate or adjudicated right to appropriate water made or held by the registrant.

.....

.....

GR- [illegible] B

Township 5S Range 2W, W.M.

North

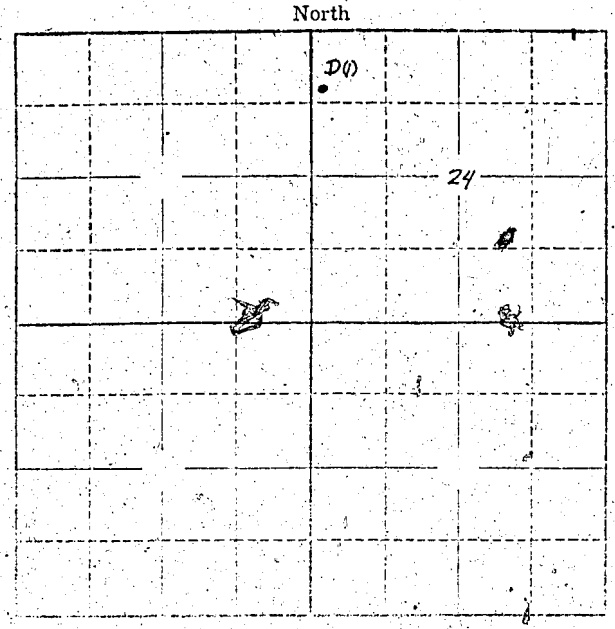

Locate well and acreage of irrigated land on plat.

Scale: 2" = 1 Mile

STATE OF OREGON
County of Marion } ss.

I, ..., being first duly sworn, do hereby certify that I have read the foregoing Registration Statement and that all of the items therein contained are true to the best of my knowledge and belief.

John R Moron
(Signature of Registrant)

Subscribed and sworn to before me this 20th day of January, 19 58.

My commission expires 12th June 1961 Wm. S. Bartholomew
(Notary Public)

(SEAL)

CERTIFICATE OF REGISTRATION

STATE OF OREGON
County of Marion } ss.

This is to certify that the foregoing Registration Statement was received in the office of the State Engineer on the 20 day of January, 19 58, at 8:00 o'clock A. M. and has been duly recorded in said office in Book No. 5 of Registration Statements on page 883

~~Granted in part, subject to prior rights, and limited to a period of one year from date hereof.~~

Witness my hand this 24 day of April, 19 58.

(State Engineer)

By .....
(Deputy)

GR-883 C