

Registration Statement

OF CLAIMANT OF RIGHT TO APPROPRIATE GROUND WATER

(Under Chapter 708, Oregon Laws 1955.)

TO THE STATE ENGINEER OF OREGON:

I, J. B. Jorgensen
 of Salem County of Marion
 State of Oregon, do hereby make application for a certificate of registration as evidence of a right to appropriate ground water.

1. Source from which water is withdrawn is pump well
(Flowing well, pump well, infiltration trench, or tunnel)
2. Location is: 7 miles northwest of Salem
(Approximate distance and direction from nearest city or town)

and is more particularly described as follows:

- (a) 23 chains north & 22 chains west from SE corner section 33, Southeast quarter of Willamette Meridian NW 1/4 of SE 1/4
(Give distance and bearing to corner of section or other legal subdivision)
- being within Southeast Quarter of Sec. 33, Twp. 6 South, R. 3 West
(Smallest legal subdivision) (N. or S.) (E. or W.)
- or (b) within limits of recorded platted property, town or city: _____

in Lot _____, Block _____ of _____
(Name of plat or addition)
 _____ County of _____
(If within city or town, give name)

3. Construction Work was begun on May 26, 1946, was completed on May 30, 1946
(Date) (Date)
- and the ground water claimed was first used for the purposes set out below on July 1946
(Date)
- since which time the water has been used as needed for irrigation
(Continuously or intermittently)
- from July 1946 to January 1956
(Date) (Date)

4. Quantity of water claimed and used is 175 gallons per minute; 9 + 4 acre feet per year.

5. Purpose or Purposes for which water is used Irrigation

(Domestic, irrigation, municipal, manufacturing, industrial, etc.)

6. Description of Well: Depth 32 feet. Type Drilled
(Dug or drilled)

diameter 4 inches. Elevation of ground at well site 96 feet, mean sea level.
(As near as known)

Depth to water table varies feet.

7. Capacity of Well: 375 g.p.m. with 22 ft feet drawdown.
 _____ g.p.m. with _____ feet drawdown.

Date of test May 1946

If Flowing Well: Measured discharge _____ g.p.m. on _____
(Date)

Shut-in pressure at ground surface _____ lbs. per sq. in. on _____
(Date)

Water is controlled by _____
(Cap, valve, etc.)

8. Casing: (Give diameter, commercial specifications and depth below ground surface of each casing size.)

4 inch diameter *straight down* from to *32* feet
 inch diameter from to feet
 inch diameter from to feet
 inch diameter from to feet

Describe and show depth of shoe, plug, adapter, liner or other details:

open bottom

9. Perforated Casings or Screens:

6 perforations to depth from to
(Number per foot and size of perforations, or describe screen)

..... from to
 from to
 from to
 from to

10. Log of Well: (Describe each stratum or formation clearly, indicate if water bearing, and give thickness and depth as indicated.)

MATERIAL	Thickness (Feet)	Depth to Bottom (Feet)
<i>Built in soil down to about 12 feet then hit a stop of sand then gravel from there on down to 18ft and all gravel on down</i>		

If log of well is not available, give name and address of driller.

11. Infiltration Trench: Covered or open

Dimensions: Length ft. Minimum depth ft. Maximum depth ft.

Bottom width ft. Discharge g.p.m. Date of test

12. Tunnel: Type of lining

Dimensions:
(Length, course, and cross sectional size)

Position of water bearing stratum with reference to portal of tunnel

Log of tunnel: (Preceding table for log of well may be used, if desired. Give footage from portal and character of materials, as pertinent.)

13. Pumping Equipment:

(a) Pump *Centrifugal - 1 1/2* Capacity *175* g.p.m.
(Make, type and size)


(b) Motor *Fairbanks-Morse* *5 horsepower*
(Type and horsepower)

14. Location of area irrigated or to be irrigated, or place of use if for purposes other than irrigation.

Township North or South	Range E. or W. of Willamette Meridian	Section	Forty-acre Tract	Number Acres To Be Irrigated	Date of Reclamation
<i>6 South</i>	<i>3 West</i>	<i>33</i>		<i>9 acres plus 4 acres custom</i>	<i>July 1946</i>
<i>6S</i>	<i>3W</i>	<i>33</i>	<i>NE 1/4 of SE 1/4</i>	<i>8</i>	<i>1946</i>
<i>6S</i>	<i>3W</i>	<i>33</i>	<i>NW 1/4 of SE 1/4</i>	<i>5</i>	<i>1946</i>

15. If the ground water supply is supplemental to an existing water supply, identification of any application for a permit, permit, certificate or adjudicated right to appropriate water made or held by the registrant.

Township 6 South Range 3 West, W.M.
North

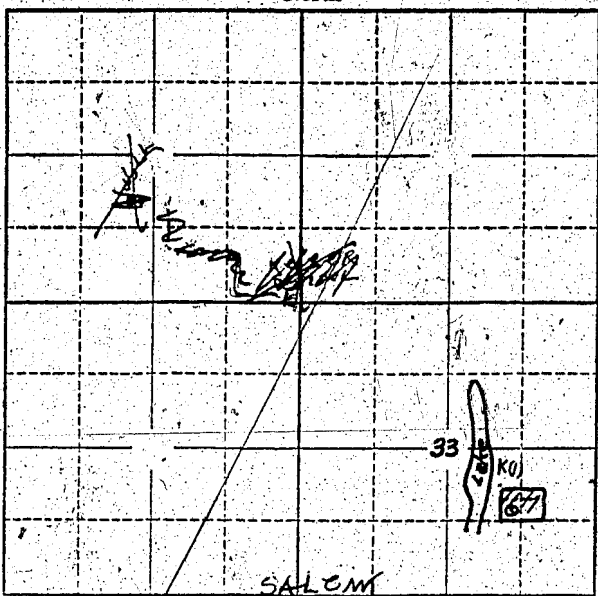

Locate well and acreage of irrigated land on plat.
Scale: 2" = 1 Mile

STATE OF OREGON }
County of Marion } ss.

I, J. B. Jorgensen, being first duly sworn, do hereby certify that I have read the foregoing Registration Statement and that all of the items therein contained are true to the best of my knowledge and belief.

J. B. Jorgensen
(Signature of Registrant)

Subscribed and sworn to before me this 26th day of January, 1956

My commission expires Sept 6, 1956
Chas. L. Miller
(Notary Public)

(SEAL)

CERTIFICATE OF REGISTRATION

STATE OF OREGON }
County of Marion } ss.

This is to certify that the foregoing Registration Statement was received in the office of the State Engineer on the 26th day of January, 1956, at 10:30 o'clock A. M. and has been duly recorded in said office in Book No. 1 of Registration Statements on page GR-87C.

Construction shall be completed by is _____, 19____, and the water is completely applied to beneficial use by _____, 19____.

Witness my hand this 12th day of April, 1956

Lewis A. Stanley
(State Engineer)

By _____
(Deputy)