

Registration Statement

OF CLAIMANT OF RIGHT TO APPROPRIATE GROUND WATER

TO THE STATE ENGINEER OF OREGON:

I, ELTON L. WATTS

of R2 B. & 271 SILVERTON County of MARION

State of OREGON, do hereby make application for a certificate of registration as evidence of a right to appropriate ground water.

1. Source from which water is withdrawn is WELL #1
(Flowing well, pump well, infiltration trench, or tunnel)

2. Location is: 5 MI. WEST OF SILVERTON
(Approximate distance and direction from nearest city or town)

and is more particularly described as follows:

(a) 1950' S & 1300' E from N.W. Corner Section 12
(Give distance and bearing to corner of section or other legal subdivision)

being within SW 1/4, NW 1/4 of Sec. 12, Twp. 7 S, Rge. 7 W
(Smallest legal subdivision) (N. or S.) (E. or W.)

or (b) within limits of recorded platted property, town or city:

in Lot _____, Block 3 of _____
(Name of plat or addition)

County of _____
(If within city or town, give name)

3. Construction Work was begun on 4-18-52; was completed on 4-18-52
(Date) (Date)

and the ground water claimed was first used for the purposes set out below on 5-28-52
(Date)

since which time the water has been used Intermittently
(Continuously or Intermittently)

from 5-28-52 to 5-28-52
(Date) (Date)

4. Quantity of water claimed and used is 360 gallons per minute; 125 acre feet per year.

5. Purpose or Purposes for which water is used IRRIGATION

(Domestic, irrigation, municipal, manufacturing, industrial, etc.)

6. Description of Well: Depth 125 feet. Type DRILLED
(Dug or drilled)

diameter 11 inches. Elevation of ground at well site _____ feet, mean sea level.
(As near as known)

Depth to water table 125 feet.

7. Capacity of Well: 480 g.p.m. with 37 feet drawdown.

375 g.p.m. with 21 feet drawdown.

Date of test 4-10-52

If Flowing Well: Measured discharge _____ g.p.m. on _____
(Date)

Shut-in pressure at ground surface _____ lbs. per sq. in. on _____
(Date)

Water is controlled by _____
(Cap, valve, etc.)

8. Casing: (Give diameter, commercial specifications and depth below ground surface of each casing size.)

10 inch diameter from 0 to 12.5 feet
 inch diameter from to feet
 inch diameter from to feet
 inch diameter from to feet

Describe and show depth of shoe, plug, adapter, liner or other details:

9. Perforated Casings or Screens:

PERFORATED 410 PERFORATIONS from 72 to 125
(Number per foot and size of perforations, or describe screen)
 from to
 from to
 from to

10. Log of Well: (Describe each stratum or formation clearly, indicate if water bearing, and give thickness and depth as indicated.)

MATERIAL	Thickness (Feet)	Depth to Bottom (Feet)
Soil	72	72
Gravel, cemented	5.1	123
Gravel, water-bearing	2	125

If log of well is not available, give name and address of driller.

J.A. SNEED & SONS 2505 BRACKS ST SALEM, ORE

11. Infiltration Trench: Covered or open

Dimensions: Length ft. Minimum depth ft. Maximum depth ft.

Bottom width ft. Discharge g.p.m. Date of test

12. Tunnel: Type of lining

Dimensions: (Length, course, and cross sectional size)

Position of water bearing stratum with reference to portal of tunnel

Log of tunnel: (Preceding table for log of well may be used, if desired. Give footage from portal and character of materials, as pertinent.)

13. Pumping Equipment:

(a) Pump BERKELEY TURBINE Capacity 430 g.p.m.
(Make, type and size)


(b) Motor U.S. MOTOR 20 H.P. 3 PHASE
(Type and horsepower)

14. Location of area irrigated or to be irrigated, or place of use if for purposes other than irrigation.

Township North or South	Range E. or W. of Willamette Meridian	Section	Forty-acre Tract	Number Acres To Be Irrigated	Date of Reclamation
7-S	2W	12	NE 1/4 NW 1/4	12 11	1952
			NW 1/4 NW 1/4	14 14	"
			SW 1/4 NW 1/4	21 20	"
			SE 1/4 NW 1/4	11 11	"
			NW 1/4 SW 1/4	8 8	"
			NE 1/4 SW 1/4	1 1	"
				65 ac	

15. If the ground water supply is supplemental to an existing water supply, identification of any application for a permit, permit, certificate or adjudicated right to appropriate water made or held by the registrant.

Township 7S Range 2W, W.M.
North

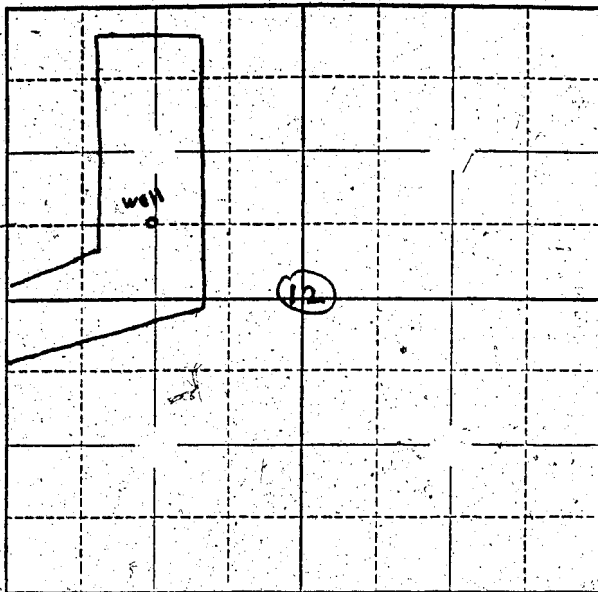

Locate well and acreage of irrigated land on plat.

Scale: $\frac{1}{4}$ " = 1 Mile

STATE OF OREGON

County of Marion

} ss.

I, _____, being first duly sworn, do hereby certify that I have read the foregoing Registration Statement and that all of the items therein contained are true to the best of my knowledge and belief.

Elton L. Statts
(Signature of Registrant)

Subscribed and sworn to before me this 21 day of January, 1958

My commission expires September 8, 1960

Marvin [Signature]
(Notary Public)

(SEAL)

CERTIFICATE OF REGISTRATION

STATE OF OREGON

County of Marion

} ss.

This is to certify that the foregoing Registration Statement was received in the office of the State Engineer on the 21 day of January, 1958, at 9:00 o'clock A. M. and has been duly recorded in said office in Book No. 5 of Registration Statements on page 887

Witness my hand this 24 day of April, 1958

Laura A. Stanley
(State Engineer)

By _____
(Deputy)