

Registration Statement

OF CLAIMANT OF RIGHT TO APPROPRIATE GROUND WATER

(Under Chapter 708, Oregon Laws 1955.)

TO THE STATE ENGINEER OF OREGON:

I, Fred Wymore

of Rt 2 Box 317 Salem County of Marion

State of Oregon, do hereby make application for a certificate of registration as evidence of a right to appropriate ground water.

1. Source from which water is withdrawn is Pump Well
(Flowing well, pump well, infiltration trench, or tunnel)

2. Location is: 7 miles north of Salem, on Quinaby Road
(Approximate distance and direction from nearest city or town)

and is more particularly described as follows:

(a) 1002 ft. North and 95 ft. West from the SE corner of Section 24
(Give distance and bearing to corner of section or other legal subdivision)

being within SE 1/4 of the SE 1/4 of Sec. 24, Twp. 6 South, Rge. 3 West
(Smallest legal subdivision) (N. or S.) (E. or W.)

or (b) within limits of recorded platted property, town or city:

in Lot _____ Block _____ of _____
(Name of plat or addition)
County of _____
(If within city or town, give name)

3. Construction Work was begun on AUG. 5 1953; was completed on AUG. 20 1953
(Date) (Date)

and the ground water claimed was first used for the purposes set out below on JUNE 10 1953
(Date)

since which time the water has been used CONTINUOUSLY in _____
(Continuously or intermittently)

from JUNE 10 1953 to D.P.
(Date) (Date)

4. Quantity of water claimed and used is 115 gallons per minute; _____ acre feet per year.

5. Purpose or Purposes for which water is used IRRIGATION AND AGRICULTURE CROPS
AND LUBS BUILDS
(Domestic, irrigation, municipal, manufacturing, industrial, etc.)

6. Description of Well: Depth 130 feet. Type Drilled (Cable Tools)
(Dug or drilled)
diameter 10 CD inches. Elevation of ground at well site 122 feet, mean sea level.
(As near as known)

Depth to water table 33 feet.

7. Capacity of Well: 580 g.p.m. with 21 feet drawdown.
_____ g.p.m. with _____ feet drawdown.

Date of test August 1953

If Flowing Well: Measured discharge _____ g.p.m. on _____
(Date)

Shut-in pressure at ground surface _____ lbs. per sq. in. on _____
(Date)

Water is controlled by _____
(Cap, valve, etc.)

8. Casing: (Give diameter, commercial specifications and depth below ground surface of each casing size.)

..... inch diameter from to feet
 inch diameter from to feet
 inch diameter from to feet
 inch diameter from to feet

Describe and show depth of shoe, plug, adapter, liner or other details:

9. Perforated Casings or Screens:

~~1/2" 10 MESH~~ from 100' to 130'
 (Number per foot and size of perforations, or describe screen)
 from to
 from to
 from to

10. Log of Well: (Describe each stratum or formation clearly, indicate if water bearing, and give thickness and depth as indicated.)

MATERIAL	Thickness (Feet)	Depth to Bottom (Feet)
TOP SOIL	0	3
CLAY	3	33
WATER BEARING YELLOW SAND	33	38
SOFT BLUE SHALE	38	76
WATER BEARING SAND	76	85
LITTLE WATER GRAVEL & SHALE	85	95
WATER SAND	95	99
WATER BEARING COURSE SAND & GRAVEL	99	114
WATER BEARING BIG SIZE GRAVEL	114	130

GR-331A

If log of well is not available, give name and address of driller.

11. **Infiltration Trench:** Covered or open

Dimensions: Length ft. Minimum depth ft. Maximum depth ft.

Bottom width ft. Discharge g.p.m. Date of test

12. **Tunnel:** Type of lining

Dimensions:
(Length, course, and cross sectional size)

Position of water bearing stratum with reference to portal of tunnel

Log of tunnel: (Preceding table for log of well may be used, if desired. Give footage from portal and character of materials, as pertinent.)

13. **Pumping Equipment:**

(a) Pump PATONA Capacity 130 g.p.m.
(Make, type and size)

(b) Motor 7 HORSE TURBINE
(Type and horsepower)


14. Location of area irrigated or to be irrigated, or place of use if for purposes other than irrigation.

Township North or South	Range E. or W. of Willamette Meridian	Section	Forty-acre Tract	Number Acres To Be Irrigated	Date of Reclamation
6 South	Range 3 West	24	SE 1/4 of SE 1/4	19.10	1956

15. If the ground water supply is supplemental to an existing water supply, identification of any application for a permit, permit, certificate or adjudicated right to appropriate water made or held by the registrant.

GR-887B

Township 6 S Range 3 W, W.M.
North

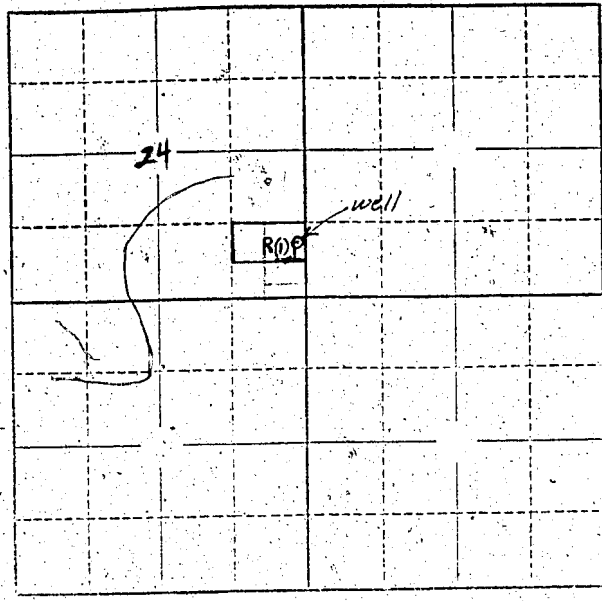

The North $\frac{1}{2}$ of the
S.E. $\frac{1}{4}$ of the SE $\frac{1}{4}$
of Section 24
Township 6 South
Range 3 West of
Willamette Meridian
Marion County, Oreg.

Locate well and acreage of irrigated land on plat.
Scale: 2" = 1 Mile

STATE OF OREGON }
County of MARION } ss.

I, Fred Wymore, being first duly sworn, do hereby certify that I have read the foregoing Registration Statement and that all of the items therein contained are true to the best of my knowledge and belief.

Fred Wymore
(Signature of Registrant)

Subscribed and sworn to before me this 15 day of JANUARY, 1958

My commission expires March 18, 1959
Harold A. Eitzen
(Notary Public)

(SEAL)

CERTIFICATE OF REGISTRATION

STATE OF OREGON }
County of Marion } ss.

This is to certify that the foregoing Registration Statement was received in the office of the State Engineer on the 22 day of January, 1958, at 8:00 o'clock A. M. and has been duly recorded in said office in Book No. 5 of Registration Statements on page 890

~~Construction shall be completed by X-X-X-X-X-X-X-X-X-X-X-X and the water completely applied to beneficial use by X-X-X-X-X-X-X-X-X-X-X-X~~

Witness my hand this 7 day of May, 1958

Harold A. Eitzen
(State Engineer)
By _____
(Deputy) GR-307C