

Registration Statement

OF CLAIMANT OF RIGHT TO APPROPRIATE GROUND WATER

TO THE STATE ENGINEER OF OREGON:

I, Frank E. Gates

of Route 1, Box 415, Albany
(Mailing address)

County of Linn

State of Oregon

, do hereby make application for a certificate of registration as evidence of a right to appropriate ground water:

1. Source from which water is withdrawn is pump well # 1
(Flowing well, pump well, infiltration trench, or tunnel)

2. Location is: 3 miles East of Jefferson, Oregon
(Approximate distance and direction from nearest city or town)

and is more particularly described as follows:

(a) S. 59° E. 8.5 chains from NW corner of SW 1/4 of S. 17 T. 10 S. R. 2W
(Give distance and bearing to corner of section or other legal subdivision)

being within NW 1/4 of SW 1/4 of Sec. 17, Twp: 10 S, Rge. 2W
(Smallest legal subdivision) (N. or S.) (E. or W.)

or (b) within limits of recorded platted property, town or city:

in Lot , Block of
(Name of plat or addition)

County of Linn
(If within city or town, give name)

3. Construction Work was begun on Jan. 1947; was completed on Jan. 1947
(Date) (Date)

and the ground water claimed was first used for the purposes set out below on June 1947
(Date)

since which time the water has been used Continuously
(Continuously or intermittently)

from June 1947 to present time
(Date) (Date)

4. Quantity of water claimed and used is 400 gallons per minute; 117 acre feet per year.

5. Purpose or Purposes for which water is used Irrigation

(Domestic, irrigation, municipal, manufacturing, industrial, etc.)

6. Description of Well: Depth 26 feet. Type drilled

(Dug or drilled)

diameter 8 inches. Elevation of ground at well site 250 feet, mean sea level.
(As near as known)

Depth to water table 3 feet.

7. Capacity of Well: 650 g.p.m. with 4 feet drawdown.

 g.p.m. with feet drawdown.

Date of test June 1947

If Flowing Well: Measured discharge g.p.m. on
(Date)

Shut-in pressure at ground surface lbs. per sq. in. on
(Date)

Water is controlled by
(Cap, valve, etc.)

8. Casing: (Give diameter, commercial specifications and depth below ground surface of each casing size.)

8 inch diameter steel casing from 0 to 26 feet
 inch diameter from to feet
 inch diameter from to feet
 inch diameter from to feet

Describe and show depth of shoe, plug, adapter, liner or other details:

9. Perforated Casings or Screens:

Slot perforations from 14 to 26
 (Number per foot and size of perforations, or describe screen)
 from to
 from to
 from to

10. Log of Well: (Describe each stratum or formation clearly, indicate if water bearing, and give thickness and depth as indicated.)

MATERIAL	Thickness (Feet)	Depth to Bottom (Feet)
Not available		

If log of well is not available, give name and address of driller. Marion West, Salem, Oregon

11. Infiltration Trench: Covered or open

Dimensions: Length ft. Minimum depth ft. Maximum depth ft.

Bottom width ft. Discharge g.p.m. Date of test

12. Tunnel: Type of lining

Dimensions:
(Length, course, and cross sectional size)

Position of water bearing stratum with reference to portal of tunnel

Log of tunnel: (Preceding table for log of well may be used, if desired. Give footage from portal and character of materials, as pertinent.)

13. Pumping Equipment:

(a) Pump 3" centrifugal Capacity 400 g.p.m.
(Make, type and size)

(b) Motor 20 H.P. Electric
(Type and horsepower)

14. Location of area irrigated or to be irrigated, or place of use if for purposes other than irrigation.


Township North or South	Range E. or W. of Willamette Meridian	Section	Forty-acre Tract	Number Acres To Be Irrigated	Date of Reclamation
10 S	2 W	17	NW $\frac{1}{4}$ of SW $\frac{1}{4}$	31.1	June 1947
10 S	2 W	17	NE $\frac{1}{4}$ of SW $\frac{1}{4}$	15.7	" "
				46.8	

DESCRIPTION OF 54.62 ACRES PIECE

Beginning at the West Quarter Corner of Section 17, in T. 10 S., R. 2 W. of W.M., Linn County, Oregon; and running thence S. 89° 59' E. along the center line of said Section 28.200 chains to a $\frac{1}{2}$ " Iron pipe, thence South 19.441 chains to a 1" Iron pipe, thence N. 89° 45' W. 28.200 chains to the center of the County Road, said point being North 20.806 chains from the Southwest Corner of said Section 17, thence North along the West line of said Section 19.302 chains to the place of beginning, containing 54.62 acres.

15. If the ground water supply is supplemental to an existing water supply, identification of any application for a permit, permit, certificate or adjudicated right to appropriate water made or held by the registrant.

Township 10 S. Range 2 W. W.M.
North

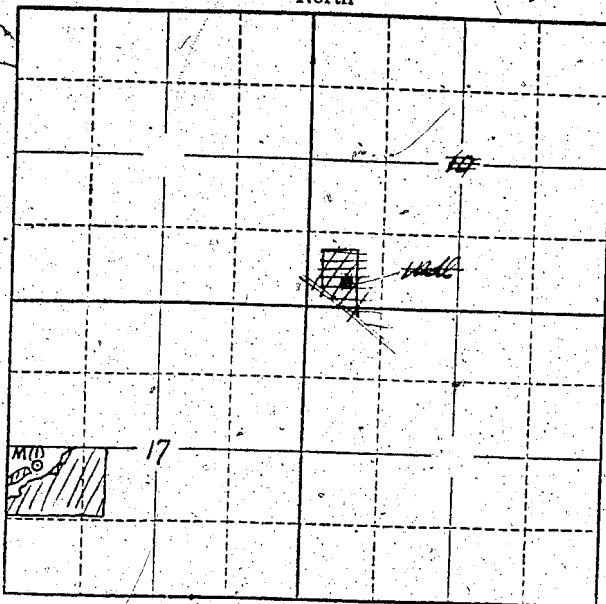

Locate well and acreage of irrigated land on plat.
Scale: 2" = 1 Mile

STATE OF OREGON

County of Linn } ss.

I, Frank E. Gates, being first duly sworn, do hereby certify that I have read the foregoing Registration Statement and that all of the items therein contained are true to the best of my knowledge and belief.

(Signature of Registrant)

Subscribed and sworn to before me this 20th day of January, 1957.

My commission expires Nov. 7, 1958

Jessie M. Primmer
(Notary Public)

(SEAL)

CERTIFICATE OF REGISTRATION

STATE OF OREGON

County of Marion } ss.

This is to certify that the foregoing Registration Statement was received in the office of the State Engineer on the _____ day of _____, 1957, at _____ o'clock _____ M. and has been duly recorded in said office in Book No. 5 of Registration Statements on page 891.

Witness my hand this 7 day of May, 1958.

[Signature]
(State Engineer)

By _____
(Deputy)