

Registration Statement

OF CLAIMANT OF RIGHT TO APPROPRIATE GROUND WATER

TO THE STATE ENGINEER OF OREGON:

I, E. J. Gates

of Route 1, Box 415, Albany County of Linn
(Mailing address)

State of Oregon, do hereby make application for a certificate of registration as evidence of a right to appropriate ground water.

1. Source from which water is withdrawn is pump well
(Flowing well, pump well, infiltration trench, or tunnel)

2. Location is: 2 miles East of Albany, Oregon
(Approximate distance and direction from nearest city or town)

and is more particularly described as follows:

(a) S. 16° 40' W. 43.5 chains from NE corner DLC 48, T. 11S., R. 3W.
(Give distance and bearing to corner of section or other legal subdivision)

being within SW₂ of SW₂ of Sec. 10, Twp. 11S, Rge. 3W
(Smallest legal subdivision) (N. or S.) (E. or W.)

or (b) within limits of recorded-platted property, town or city:

in Lot _____, Block _____ of _____
(Name of plat or addition)

County of Linn
(If within city or town, give name)

3. Construction Work was begun on Nov. 19, 1954; was completed on Nov 20, 1954
(Date) (Date)

and the ground water claimed was first used for the purposes set out below on June 5, 1955
(Date)

since which time the water has been used continuously on 1 acre
(Continuously or intermittently)

from June 5, 1955 to present time
(Date) (Date)

4. Quantity of water claimed and used is 25⁰⁰ gallons per minute; 2.5 acre feet per year.

5. Purpose or Purposes for which water is used Irrigation
(Domestic, irrigation, municipal, manufacturing, industrial, etc.)

6. Description of Well: Depth 108 feet. Type Drilled
(Dug or drilled)

diameter 8 inches. Elevation of ground at well site 240 feet, mean sea level.
(As near as known)

Depth to water table 10 feet.

7. Capacity of Well: 50 g.p.m. with 40 feet drawdown.

 g.p.m. with feet drawdown.

Date of test Nov. 20, 1954

If Flowing Well: Measured discharge g.p.m. on
(Date)

Shut-in pressure at ground surface lbs. per sq. in. on
(Date)

Water is controlled by
(Cap, valve, etc.)

If log of well is not available, give name and address of driller. Slate Drilling Co., Tangent, Oregon

11. Infiltration Trench: Covered or open

Dimensions: Length ft. Minimum depth ft. Maximum depth ft.

Bottom width ft. Discharge g.p.m. Date of test

12. Tunnel: Type of lining

Dimensions:
(Length, course, and cross sectional size)

Position of water bearing stratum with reference to portal of tunnel

Log of tunnel: (Preceding table for log of well may be used, if desired. Give footage from portal and character of materials, as pertinent.)

13. Pumping Equipment:

(a) Pump Meyers Deep Well Jet Capacity 30 g.p.m.
(Make, type and size)

(b) Motor 1 H.P. Electric
(Type and horsepower)

14. Location of area irrigated or to be irrigated, or place of use if for purposes other than irrigation.


Township North or South	Range E. or W. of Willamette Meridian	Section	Forty-acre Tract	Number Acres To Be Irrigated	Date of Reclamation
11 S	3 W	10	SW $\frac{1}{4}$ of SW $\frac{1}{4}$	19.9	Not used
11 S	3 W	15	NW $\frac{1}{4}$ of NW $\frac{1}{4}$	0.3 20.2	Not used
Only one acre in SW $\frac{1}{4}$ of SW $\frac{1}{4}$, S. 10, T. 11S., R. 3W., has been irrigated, but the well was drilled to 108 feet in order to get enough water to irrigate the 20.2 acres. It is planned to irrigate the entire area sometime in the future.					
11 S	3 W	10	SW $\frac{1}{4}$ of SW $\frac{1}{4}$	1.0	1954

his heirs and assigns, the following described premises, situated in Linn County, Oregon, to-wit:

Beginning at a point 27.87 chains South and West 16.70 chains distant from the Northeast corner of the E. N. White D.L.C., Not. No. 694, Claim 48, T. 11 S., R. 3 W. of the W.M.; thence South 17.47 chains; thence North 59°45' West 6.37 chains; thence North 14.26 chains; thence East 5.50 chains to the place of beginning. ALSO, Beginning at a point 27.87 chains South and West 10.28 chains from the Northwest corner of the E. N. White D.L.C. Not. 694, Claim 48, T. 11 S., R. 3 W. of the W.M.; thence South 21.22 chains; thence North 59°45' West 7.44 chains; thence North 17.47 chains; thence East 6.42 chains to the place of beginning.

15. If the ground water supply is supplemental to an existing water supply, identification of any application for a permit, permit, certificate or adjudicated right to appropriate water made or held by the registrant.

Township 11S Range 3W, W.M.
North

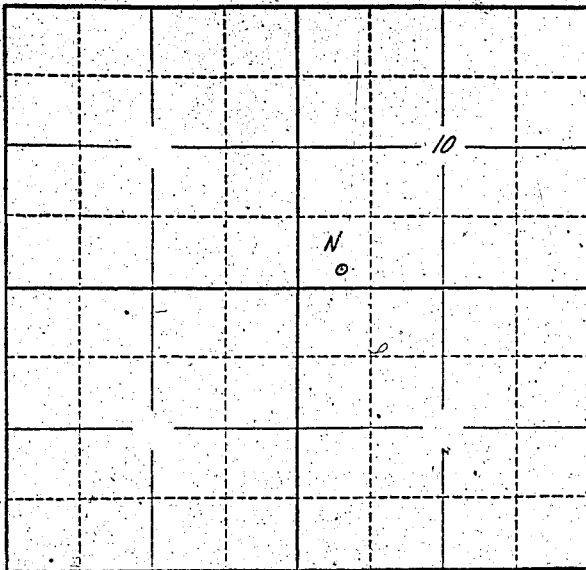

Locate well and acreage of irrigated land on plat.
Scale: 2" = 1 Mile

STATE OF OREGON

County of Linn } ss.

I, E. L. Gates, being first duly sworn, do hereby certify that I have read the foregoing Registration Statement and that all of the items therein contained are true to the best of my knowledge and belief.

E. L. Gates
E. L. Gates
(Signature of Registrant)

Subscribed and sworn to before me this 20th day of January, 1958.

My commission expires Nov. 7, 1958

Jessie M. Pessiman
(Notary Public)

(SEAL)

CERTIFICATE OF REGISTRATION

STATE OF OREGON

County of Marion } ss.

This is to certify that the foregoing Registration Statement was received in the office of the State Engineer on the 20th day of January, 1958, at 5:00 o'clock P.M. and has been duly recorded in said office in Book No. 11 of Registration Statements on page GR 244!

Witness my hand this 16th day of March, 1959.

Lewis A. Stanley
(State Engineer)

#15.00.

By _____ (Deputy)

GR 244!