

Registration Statement

OF CLAIMANT OF RIGHT TO APPROPRIATE GROUND WATER

TO THE STATE ENGINEER OF OREGON:

I, LEWIS B. McBEE

of P.O. BOX 465 SPRINGFIELD County of LANE

State of OREGON do hereby make application for a certificate of registration as evidence of a right to appropriate ground water

1. Source from which water is withdrawn is PUMP WELL
(Flowing well, pump well, infiltration trench, or tunnel)

2. Location is: 1 MILE S.E. OF SPRINGFIELD, ORE.
(Approximate distance and direction from nearest city or town)

and is more particularly described as follows:

(a) S. 50° 30' E. 1170' FROM THE S.W. COR. OF THE 13.8 AC. BRIGGS D.L.C. NO. 83
(Give distance and bearing to corner of section or other legal subdivision)

being within NW 1/4 SE 1/4 of Sec. 1, Twp. 18 S, Rge. 3 W
(Smallest legal subdivision) (N. or S.) (E. or W.)

or (b) within limits of recorded platted property, town or city:

in Lot _____, Block _____ of _____
(Name of plat or addition)

County of _____
(If within city or town, give name)

3. Construction Work was begun on MAY 1952; was completed on MAY 1952
(Date) (Date)

and the ground water claimed was first used for the purposes set out below on JULY 1952
(Date)

since which time the water has been used EACH YEAR
(Continuously or Intermittently)

from JULY 1952 to PRESENT
(Date) (Date)

4. Quantity of water claimed and used is 160 gallons per minute; 4.5 acre feet per year.

5. Purpose or Purposes for which water is used IRRIGATION

(Domestic, irrigation, municipal, manufacturing, industrial, etc.)

6. Description of Well: Depth 21 feet. Type 3-2" PIPES DRIVEN
(Dug or drilled)

diameter 3-2" inches. Elevation of ground at well site 425 feet; mean sea level.
(As near as known)

Depth to water table _____ feet.

7. Capacity of Well: _____ g.p.m. with _____ feet drawdown.

_____ g.p.m. with _____ feet drawdown.

Date of test _____

If Flowing Well: Measured discharge _____ g.p.m. on _____
(Date)

Shut-in pressure at ground surface _____ lbs. per sq. in. on _____
(Date)

Water is controlled by _____
(Cap. valve, etc.)

8. Casing: (Give diameter, commercial specifications and depth below ground surface of each casing size.)

2" inch diameter STEEL PIPE from SURFACE to 21 feet
 inch diameter from to feet
 inch diameter from to feet
 inch diameter from to feet

Describe and show depth of shoe, plug, adapter, liner or other details:

9. Perforated Casings or Screens:

(Number per foot and size of perforations, or describe screen) from to
 from to
 from to
 from to

10. Log of Well: (Describe each stratum or formation clearly, indicate if water bearing, and give thickness and depth as indicated.)

MATERIAL	Thickness (Feet)	Depth to Bottom (Feet)
LOAM	8'	13'
SANDY GRAVEL	15'	0'

If log of well is not available, give name and address of driller.

11. Infiltration Trench: Covered or open
 Dimensions: Length ft. Minimum depth ft. Maximum depth ft.
 Bottom width ft. Discharge g.p.m. Date of test

12. Tunnel: Type of lining
 Dimensions:
(Length, course, and cross sectional size)
 Position of water bearing stratum with reference to portal of tunnel

Log of tunnel: (Preceding table for log of well may be used, if desired. Give footage from portal and character of materials, as pertinent.)

13. Pumping Equipment:

(a) Pump FM & CO. CENT. 1 1/2" Capacity 275 g.p.m.
(Make, type and size)
 (b) Motor 20 HP GAS ENGINE
(Type and horsepower)

14. Location of area irrigated or to be irrigated, or place of use if for purposes other than irrigation.

Township North or South	Range E. or W. of Willamette Meridian	Section	Forty-acre Tract	Number Acres To Be Irrigated	Date of Reclamation
18 S	3 W	1	SW 1/4 NE 1/4	5.0	July 1952
"	"	"	NW 1/4 SE 1/4	8.0	"
"	"	"	NE 1/4 SW 1/4	3.3	"
				<u>16.3</u>	


REMARKS:-

THIS SOURCE IS ONLY USED WHEN BOOTH-KELLY LBR. CO. CLOSE DOWN THEIR PLANT FOR 2 WEEKS IN THE SUMMER THEN SINCE THE OVERFLOW FROM THEIR MILL RACE STOPS, THE SLOUGH I NORMALLY PUMP FROM DRIES UP, SO I USE THIS SOURCE TO WATER AS MUCH AS I CAN.

15. If the ground water supply is supplemental to an existing water supply, identification of any application for a permit, permit, certificate or adjudicated right to appropriate water made or held by the registrant.

SEE REMARKS ABOVE - I HAVE MADE APPLICATION FOR A WATER PERMIT FROM THE SLOUGH MENTIONED ABOVE.

Township 18.3 Range 3 W, W.M.
North

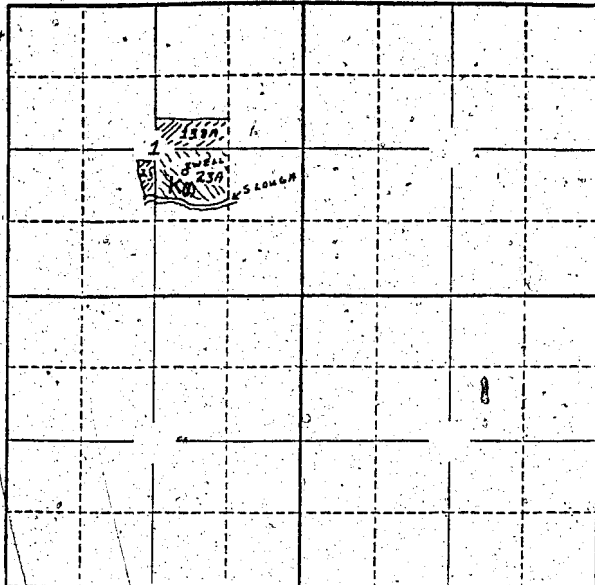

Locate well and acreage of irrigated land on plat.
Scale: 2" = 1 Mile

STATE OF OREGON

County of Lake } ss.

I, Lewis B. McBeck, being first duly sworn, do hereby certify that I have read the foregoing Registration Statement and that all of the items therein contained are true to the best of my knowledge and belief.

Lewis B. McBeck
(Signature of Registrant)

Subscribed and sworn to before me this 7th day of January, 1958

My commission expires Commission Expires February 1, 1961
Robert [Signature]
(Notary Public)

(SEAL)

CERTIFICATE OF REGISTRATION

STATE OF OREGON } ss.
County of Marion

This is to certify that the foregoing Registration Statement was received in the office of the State Engineer on the 7th day of January, 1958, at _____ o'clock _____ M. and has been duly recorded in said office in Book No. 5 of Registration Statements on page 896.

Witness my hand this 7 day of May, 1958.

Laura A. Blain
(State Engineer)

By _____ (Deputy)