

Registration Statement

OF CLAIMANT OF RIGHT TO APPROPRIATE GROUND WATER

(Under Chapter 708, Oregon Laws 1955.)

TO THE STATE ENGINEER OF OREGON:

I, John J. and Mildred E. Loy
of Route 1, Box 267, Albany County of Linn

State of Oregon, do hereby make application for a certificate of registration as evidence of a right to appropriate ground water.

1. Source from which water is withdrawn is pump well #1
(Flowing well, pump well, infiltration trench, or tunnel)

2. Location is: 3 miles NE of Albany, Oregon
(Approximate distance and direction from nearest city or town)

and is more particularly described as follows:

(a) 100 Feet S. and 2508 E. of NW corner of S. 5, T. 10S., R. 2 W.
(Give distance and bearing to corner of section or other legal subdivision)

being within NE 1/4 of NW 1/4 of Sec. 5, Twp. 10 S., Rge. 2 W.
(Smallest legal subdivision) (N. or S.) (E. or W.)

or (b) within limits of recorded platted property, town or city:

in Lot _____, Block _____ of _____
(Name of plat or addition)

County of Linn
(If within city or town, give name)

3. Construction Work was begun on June 1, 1951; was completed on June 1, 1951
(Date) (Date)

and the ground water claimed was first used for the purposes set out below on June 15, 1951
(Date)

since which time the water has been used Continuously
(Continuously or intermittently)

from June 15, 1951 to present time
(Date) (Date)

4. Quantity of water claimed and used is 280 gallons per minute; 75 acre feet per year.

5. Purpose or Purposes for which water is used Irrigation

(Domestic, irrigation, municipal, manufacturing, industrial, etc.)

6. Description of Well: Depth 26 feet. Type Drilled
(Dug or drilled)

diameter 6 inches. Elevation of ground at well site 250 feet, mean sea level.
(As near as known)

Depth to water table 11 feet.

7. Capacity of Well: 400 g.p.m. with 5 feet drawdown.

 g.p.m. with feet drawdown.


Date of test Estimated

If Flowing Well: Measured discharge g.p.m. on
(Date)

Shut-in pressure at ground surface lbs. per sq. in. on
(Date)

Water is controlled by
(Cap, valve, etc.)

Township 10S. 1/3 Range 2W. W.M.
North

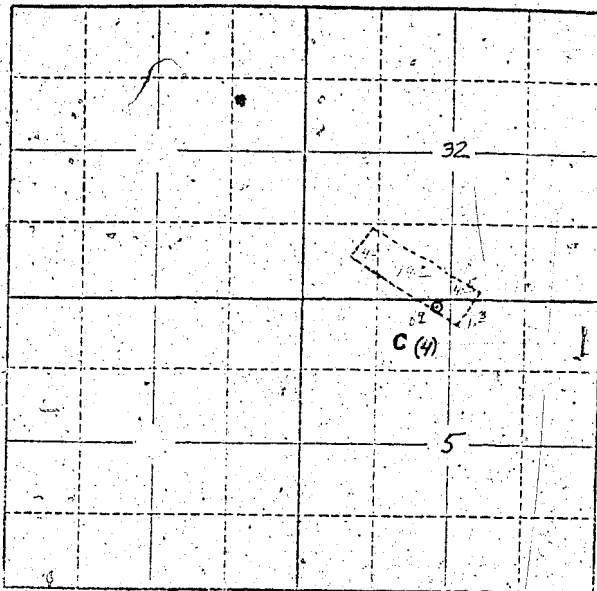

Locate well and acreage of irrigated land on plat.

Scale: 2" = 1 Mile

STATE OF OREGON

County of Linn } ss.

I, John and Mildred E. Loy, being first duly sworn, do hereby certify that I have read the foregoing Registration Statement and that all of the items therein contained are true to the best of my knowledge and belief.

John Loy
Mildred E. Loy
(Signature of Registrant)

Subscribed and sworn to before me this 7 day of May, 1958.

My commission expires 12/31/58 (Notary Public)

(SEAL)

CERTIFICATE OF REGISTRATION

STATE OF OREGON } ss.
County of Marion

This is to certify that the foregoing Registration Statement was received in the office of the State Engineer on the 7 day of May, 1958, at 10 o'clock A.M. and has been duly recorded in said office in Book No. 5 of Registration Statements on page 908.

~~Construction shall be completed by 1958 and the water completely applied to beneficial use by 1958.~~

Witness my hand this 7 day of May, 1958.

Lewis A. Atwater
(State Engineer)

By (Deputy)

GR-908 C