

Registration Statement

OF CLAIMANT OF RIGHT TO APPROPRIATE GROUND WATER

TO THE STATE ENGINEER OF OREGON:

I, Herman G. Hahn

of RT 2 BOX 287 (Mailing address)

County of Millican

State of Oregon

do hereby make application for a certificate of registration as evidence of a right to appropriate ground water.

1. Source from which water is withdrawn is Pump well #1
(Flowing well, pump well, infiltration trench, or tunnel)

2. Location is: 2 1/2 mi South-East of Gervais
(Approximate distance and direction from nearest city or town)

and is more particularly described as follows:

(a) 1950 feet south E 50 feet east from NW corner section 2
(Give distance and bearing to corner of section or other legal subdivision)

being within SW 1/4 of NW 1/4 of Sec. 2 Twp. 6 S Rge. 3 E
(Smallest legal subdivision) (N. or S.) (E. or W.)

or (b) within limits of recorded platted property, town or city:

in Lot _____, Block _____ of _____
(Name of plat or addition)

County of _____
(If within city or town, give name)

3. Construction Work was begun on March 21 1955; was completed on May 5 1955
(Date) (Date)

and the ground water claimed was first used for the purposes set out below on Aug 1955
(Date)

since which time the water has been used Intermittently
(Continuously or intermittently)

from Aug 2 1955 to Sept 1955
(Date) (Date)

4. Quantity of water claimed and used is 200 gallons per minute; _____ acre feet per year.

5. Purpose or Purposes for which water is used _____

Irrigation
(Domestic, irrigation, municipal, manufacturing, industrial, etc.)

6. Description of Well: Depth 16.6 feet. Type Drilled
(Dug or drilled)

diameter 10 inches. Elevation of ground at well site 178 feet, mean sea level.
(As near as known)

Depth to water table 2.2 feet.

7. Capacity of Well: 350 g.p.m. with 10 feet drawdown.

220 g.p.m. with 6.9 feet drawdown.

Date of test May 5 1955

If Flowing Well: Measured discharge _____ g.p.m. on _____
(Date)

Shut-in pressure at ground surface _____ lbs. per sq. in. on _____
(Date)

Water is controlled by _____
(Cap. valve, etc.)

8. Casing: (Give diameter, commercial specifications and depth below ground surface of each casing size.)

..... inch diameter from to feet
 inch diameter from to feet
 inch diameter from to feet
 10 1/2 inch diameter Standard Black pipe 51.5 from 94.5 to 156 feet

Describe and show depth of shoe, plug, adapter, liner or other details: ~~16 1/2" 1" plug~~


9. Perforated Casings or Screens:

17 wires 1/16 inch dia screen from 35 to 114
 (Number per foot and size of perforations, or describe screen)
 Total of 170 cuts in all wells in adapter from to
 from to
 from to

10. Log of Well: (Describe each stratum or formation clearly, indicate if water bearing, and give thickness and depth as indicated.)

MATERIAL	Thickness (Feet)	Depth to Bottom (Feet)
TOPSOIL	2.5	0
RED CLAY	2	2.5
Common SILT	17	19.5
BLUE SHALE	20	39.5
BLACK SAND	6.4	45.9
SANDY BLUE SILT	27	72.9
GRAY SAND	2.5	75.4
BLACK SAND	1.5	76.9
BROWN SANDY CLAY	12.6	89.5
BLUE SAND	1.5	91.0

Township 6.5 Range 2.W W.M.
North

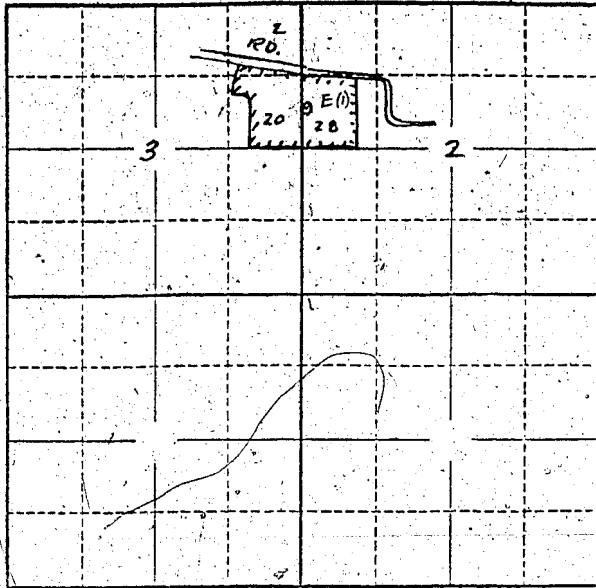

Locate well and acreage of irrigated land on plat.

Scale: 2" = 1 Mile

STATE OF OREGON

County of Marion

} ss.

I, _____, being first duly sworn, do hereby certify that I have read the foregoing Registration Statement and that all of the items therein contained are true to the best of my knowledge and belief.

Hermon G. Baker
(Signature of Registrant)

Subscribed and sworn to before me this 24th day of January, 1958.

My commission expires 12th June 1961

Wm. S. Bartholomew
(Notary Public)

(SEAL)

CERTIFICATE OF REGISTRATION

STATE OF OREGON

County of Marion

} ss.

This is to certify that the foregoing Registration Statement was received in the office of the State Engineer on the 24 day of January, 1958, at 2:30 o'clock P.M. and has been duly recorded in said office in Book No. 5 of Registration Statements on page 902.

Witness my hand this 7 day of May, 1958.

(State Engineer)

By _____

(Deputy)