

If log of well is not available, give name and address of driller. *Wilcox Drilling Co.*

11. Infiltration Trench: *Covered or open*
 Dimensions: Length ft. Minimum depth ft. Maximum depth ft.
 Bottom width ft. Discharge g.p.m. Date of test

12. Tunnel: Type of lining
 Dimensions:
 (Length, course, and cross sectional size)
 Position of water bearing stratum with reference to portal of tunnel

Log of tunnel: (Preceding table for log of well may be used, if desired. Give footage from portal and character of materials, as pertinent.)

13. Pumping Equipment:
 (a) Pump *Fairbanks-Morse Turbine* Capacity *125* g.p.m.
 (Make, type and size)
 (b) Motor *5HP Electric*
 (Type and horsepower)

14. Location of area irrigated or to be irrigated, or place of use if for purposes other than irrigation.

Township North or South	Range E. or W. of Willamette Meridian	Section	Forty-acre Tract	Number Acres To Be Irrigated	Date of Reclamation
2 S.	3 W.	31	SE _{1/4} of SE _{1/4}	16 Acres	1951
"	"	32	SW _{1/4} of SW _{1/4}	3 Acres	"
3 S.	"	5	NW _{1/4} of NW _{1/4}	18 Acres	"
"	"	"	SW _{1/4} of NE _{1/4}	31 Acres	"
"	"	"	SW _{1/4} of NW _{1/4}	1 Acre	"
"	"	6	E _{1/2} of NE _{1/4}	17 Acres	"
"	"	"	SE _{1/4} of NE _{1/4}	5 Acres	"
Total to be irrigated				91 Acres	"

Legal Description


Beginning where compromise tree as called for in Government notes; Thence S. 7° 02' W. along line between Kinney & Marble DLC's 23.27 chains; Thence S. 8° 15' W. 3.09 chains; Thence S. 87° 02' W. parallel to N. line of Kinney claim 7.165 chains; Thence S. 24.63 chains on division line as established in C. S. 1145; Thence N. 89° 45' E. 42 chains to center of Co. Rd.; Thence N. 46° 34' W. 6.09 chains; Thence N. 30° 13' W. 7.03 chains; Thence N. 26° 44' W. 1.63 chains; Thence N. 14° 44' W. 8.33 chains; Thence N. 75° 29' E. 3.73 chains; Thence N. 35° 52' E. 10.68 chains to N. line of claim; Thence W. along claim line 10.29 chains to beginning. Containing 100 acres

Part of R. C. Kinney DLC; Beginning 21.555 chains W. of N. E. corner said claim; W. 16.183 chains; S. 35° 52' W. 10.68 chains; S. 75° 29' W. 3.75 chains; S. 14° 44' E. 8.03 chains; S. 26° 44' E. 1.63 chains; S. 30° 13' E. 2.568 chains; N. 45° E. 29.719 chains to beginning. Containing 25 acres.

Beginning at SW corner John Marble DLC; Thence N. 22° W. 17.98 chains; Thence N. 67° 32' E. 26.68 chains. to center Co. Rd.; Thence S. 25° 17' E. along center Co. Rd. 12.65 chains; Thence N. 89° 27' E. 4.15 chains.; Thence N. 58° E. 7.85 chains; Thence S. 19° 17' E. 18.90 chains; Thence W. 7.98 chains to compromise corner.; Thence S. 87° 2' W. 32.496 chains to beginning.

Except County Road
 Except Sold Vo. 135, page 259 Leaving 62.16 acres

Township 3S Range 3W W.M.
North

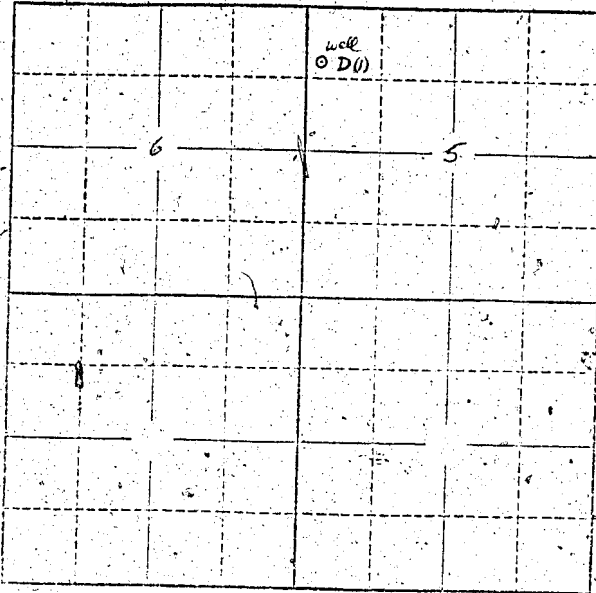

See map in
Application 32083

Locate well and acreage of irrigated land on plat
Scale: 2" = 1 Mile

STATE OF OREGON

County of Marion Co. ss:

I, _____, being first duly sworn, do hereby certify that I have read the foregoing Registration Statement and that all of the items therein contained are true, to the best of my knowledge and belief.

E. R. Baker

(Signature of Registrant)

Subscribed and sworn to before me this 27th day of January, 1958.

My commission expires 12th June 1961

Wm. D. Bartholomew

(Notary Public)

(SEAL)

CERTIFICATE OF REGISTRATION

STATE OF OREGON

County of Marion ss:

This is to certify that the foregoing Registration Statement was received in the office of the State Engineer on the 27 day of January, 1958, at 3:40 o'clock P.M. and has been duly recorded in said office in Book No. 5 of Registration Statements on page 911

~~Construction shall be completed by _____ and the water completely applied to beneficial use by _____~~

Witness my hand this 7 day of May, 1958

(State Engineer)

By _____
(Deputy)

GR-911 C