

RECEIVED
JAN 27 1956
STATE ENGINEER
GAINES OREGON

Registration Statement

REGISTRATION NO. GR-94
CERTIFICATE NO. GR-90

OF CLAIMANT OF RIGHT TO APPROPRIATE GROUND WATER

(Under Chapter 708, Oregon Laws 1955.)

TO THE STATE ENGINEER OF OREGON:

I, Philip and Amelia Roth
of Rt. 1, Box 359, Albany County of Linn
State of Oregon, do hereby make application for a certificate of registration as evidence
of a right to appropriate ground water.

1. Source from which water is withdrawn is Pump well #2
(Flowing well, pump well, infiltration trench, or tunnel)

2. Location is: 6 1/2 miles SE of Albany, Oregon
(Approximate distance and direction from nearest city or town)

and is more particularly described as follows:

(a) S. 48 1/2° W. 13.5 chains from the NE corner of S. 26, T. 11 S., R. 3 W.
(Give distance and bearing to corner of section or other legal subdivision)

being within NE 1/4 of NE 1/4 of Sec. 26, Twp. 11 S., Rge. 3 W.
(Smallest legal subdivision) (N. or S.) (E. or W.)

or (b) within limits of recorded platted property, town or city:

in Lot _____, Block _____ of _____
(Name of plat or addition)

County of Linn
(If within city or town, give name)

3. Construction Work was begun on Oct. 23, 1952; was completed on Nov. 6, 1952
(Date) (Date)

and the ground water claimed was first used for the purposes set out below on May 15, 1953
(Date)

since which time the water has been used continuously
(Continuously or Intermittently)

from May 15, 1953 to present time
(Date) (Date)

4. Quantity of water claimed and used is 147 gallons per minute; 55 acre
feet per year.

5. Purpose or Purposes for which water is used Irrigation

(Domestic, irrigation, municipal, manufacturing, industrial, etc.)

6. Description of Well: Depth 151 feet. Type drilled
(Dug or drilled)

diameter 8 inches. Elevation of ground at well site 272 feet, mean sea level.
(As near as known)

Depth to water table 14 feet

7. Capacity of Well: 225 g.p.m. with 120 feet drawdown.

120 g.p.m. with 70 feet drawdown.

Date of test Nov. 6, 1952

If Flowing Well: Measured discharge _____ g.p.m. on _____
(Date)

Shut-in pressure at ground surface _____ lbs. per sq. in. on _____
(Date)

Water is controlled by _____
(Cap, valve, etc.)

8. Casing: (Give diameter, commercial specifications and depth below ground surface of each casing size.)

8 inch diameter Plain end, welded pipe from 0 to 151 feet
inch diameter from to feet
inch diameter from to feet
inch diameter from to feet

Describe and show depth of shoe, plug, adapter, liner or other details:

9. Perforated Casings or Screens:

Slits cut with torch from 132 to 151
(Number per foot and size of perforations, or describe screen)
Mills perforator from 112 to 120
Mills perforator from 74 to 90
from to

10. Log of Well: (Describe each stratum or formation clearly, indicate if water bearing, and give thickness and depth as indicated.)

| MATERIAL | Thickness (Feet) | Depth to Bottom (Feet) |
|-----------------------|------------------|------------------------|
| Clay (light) | 11 | 11 |
| Clay & gravel (light) | 31 | 42 |
| Sand and clay | 15 | 57 |
| Clay (dark) | 17 | 74 |
| Gravel (dark) | 16 | 90 |
| Clay & gravel (dark) | 46 | 136 |
| Sand & clay (dark) | 8 | 144 |
| Gravel & clay (dark) | 7 | 151 |
| | | |
| | | |
| | | |
| | | |
| | | |
| | | |
| | | |
| | | |
| | | |
| | | |
| | | |

GR-90 A

If log of well is not available, give name and address of driller.

11. Infiltration Trench: Covered or open

Dimensions: Length ft. Minimum depth ft. Maximum depth ft.

Bottom width ft. Discharge g.p.m. Date of test

12. Tunnel: Type of lining

Dimensions:
(Length, course, and cross sectional size)

Position of water bearing stratum with reference to portal of tunnel

Log of tunnel: (Preceding table for log of well may be used, if desired. Give footage from portal and character of materials, as pertinent.)

13. Pumping Equipment:

(a) Pump Berkeley turbine pump Capacity 150 g.p.m.
(Make, type and size)


(b) Motor 10 H.P. electric
(Type and horsepower)

14. Location of area irrigated or to be irrigated, or place of use if for purposes other than irrigation.

| Township North or South | Range E. or W. of Willamette Meridian | Section | Forty-acre Tract | Number Acres To Be Irrigated | Date of Reclamation |
|----------------------------|--|---------|--------------------------------------|---------------------------------|------------------------|
| 10 S. | 3 W. | 26 | NE $\frac{1}{4}$ of NE $\frac{1}{4}$ | 29.0 | May 15, 1953 |
| | | | | | |
| | | | | | |
15. If the ground water supply is supplemental to an existing water supply, identification of any application for a permit, permit, certificate or adjudicated right to appropriate water made or held by the registrant.

Township 11.5 Range 3.4 W.M.
North

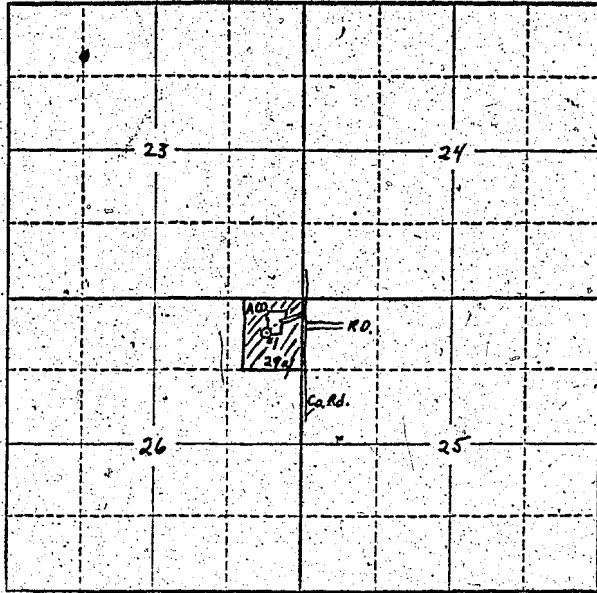

Locate well and acreage of irrigated land on plat.

Scale: 2" = 1 Mile

STATE OF OREGON

County of Linn

} ss.

I, Philip and Amelia Roth, being first duly sworn, do hereby certify that I have read the foregoing Registration Statement and that all of the items therein contained are true to the best of my knowledge and belief.

Philip Roth
Amelia Roth
(Signature of Registrant)

Subscribed and sworn to before me this 25th day of January, 1956

My commission expires

[Signature]
County Clerk

INDEXED

(SEAL)

CERTIFICATE OF REGISTRATION

STATE OF OREGON

County of Marion

} ss.

This is to certify that the foregoing Registration Statement was received in the office of the State Engineer on the 27th day of January, 1956, at 8:00 o'clock A. M. and has been duly recorded in said office in Book No. 1 of Registration Statements on page GR-90C

Construction ^{is} shall be completed by _____, 19____, and the water ^{is} completely applied to beneficial use by _____, 19____.

Witness my hand this 12th day of April, 1956

Lewis A. Atanley
(State Engineer)

By _____
(Deputy)