

# Registration Statement

## OF CLAIMANT OF RIGHT TO APPROPRIATE GROUND WATER

TO THE STATE ENGINEER OF OREGON:

I, Merwin L. and Grace J. Vannice

of Rt. 1, Halsey County of Linn

(Mailing address)

State of Oregon, do hereby make application for a certificate of registration as evidence of a right to appropriate ground water.

1. Source from which water is withdrawn is Pump Well No. 1  
(Flowing well, pump well, infiltration trench, or tunnel)

2. Location is: h miles SE of Halsey, Oregon  
(Approximate distance and direction from nearest city or town)

and is more particularly described as follows:

(a) S. 9° 58' W. 4.72 chains from NE corner of S. 17, T. 14 S., R. 3 W.  
(Give distance and bearing to corner of section or other legal subdivision)

being within NE 1/4 of NE 1/4 of Sec. 17, Twp. 14 S., Rge. 3 W.  
(Smallest legal subdivision) (N. or S.) (E. or W.)

or (b) within limits of recorded platted property, town or city

in Lot \_\_\_\_\_, Block \_\_\_\_\_ of \_\_\_\_\_  
(Name of plat or addition)

County of Linn  
(If within city or town, give name)

3. Construction Work was begun on July 15, 1955; was completed on July 19, 1955  
(Date) (Date)

and the ground water claimed was first used for the purposes set out below on July 20, 1955  
(Date)

since which time the water has been used continuously  
(Continuously or Intermittently)

from July 20, 1955 to present time  
(Date) (Date)

4. Quantity of water claimed and used is 25 gallons per minute; 10 acre feet per year.

5. Purpose or Purposes for which water is used Irrigation

(Domestic, irrigation, municipal, manufacturing, industrial, etc.)

6. Description of Well: Depth 60 feet. Type Drilled  
(Dug or drilled)

diameter 6 inches. Elevation of ground at well site 295 feet, mean sea level.  
(As near as known)

Depth to water table 10 feet.

7. Capacity of Well: 25 g.p.m. with 20 feet drawdown.

         g.p.m. with          feet drawdown.

Date of test Estimated - not tested

If flowing Well: Measured discharge          g.p.m. on           
(Date)

Shut-in pressure at ground surface          lbs. per sq. in. on           
(Date)

Water is controlled by           
(Cap, valve, etc.)



If log of well is not available, give name and address of driller. Slate Drilling Co., Tualatin, Oregon

11. Infiltration Trench: Covered or open .....  
 Dimensions: Length ..... ft. Minimum depth ..... ft. Maximum depth ..... ft.

Bottom width ..... ft. Discharge ..... g.p.m. Date of test .....

12. Tunnel: Type of lining .....

Dimensions: ..... Length, course, and cross-sectional area .....

Position of water bearing stratum with reference to portal of tunnel .....

Log of tunnel: (Preceding table for log of well may be used, if desired. Give footage from portal and character of materials, as pertinent.)

13. Pumping Equipment:

(a) Pump Deep well jet ..... Capacity 50 ..... g.p.m.  
 (Make, type and size)

(b) Motor 1 H. P. electric .....  
 (Type and horsepower)

14. Location of area irrigated or to be irrigated, or place of use if for purposes other than irrigation.


Township North or South	Range E. or W. of Willamette-Meridian	Section	Forty-acre Tract	Number Acres To Be Irrigated	Date of Reclamation
14 S	3 W	16	NW $\frac{1}{4}$ of NW $\frac{1}{4}$	1.5	July 23, 1935
14 S	3 W	17	NE $\frac{1}{4}$ of NE $\frac{1}{4}$	2.5	July 23, 1935
				4.0	



15. If the ground water supply is supplemental to an existing water supply, identification of any application for a permit, permit, certificate or adjudicated right to appropriate water made or held by the registrant.

Township 14 S Range 3 W, W.M.

North

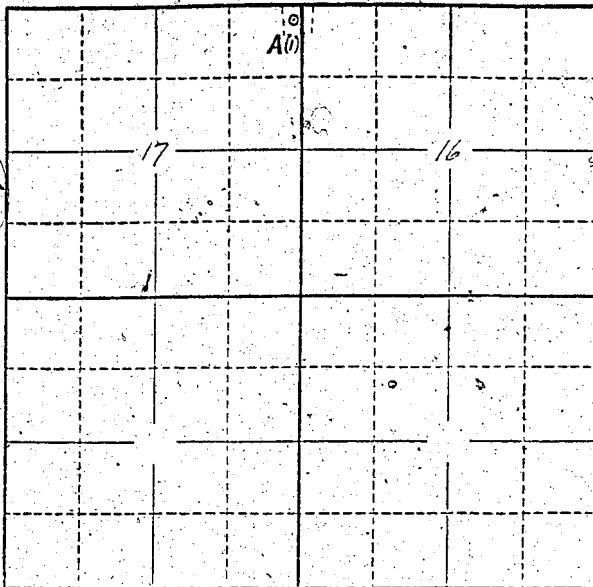

Locate well and acreage of irrigated land on plat.

Scale: 2" = 1 Mile

STATE OF OREGON

County of LINN } ss

I, Merwin L. and Grace J. Vannice, being first duly sworn, do hereby certify that I have read the foregoing Registration Statement and that all of the items therein contained are true to the best of my knowledge and belief.

*Merwin L. Vannice*  
\_\_\_\_\_  
(Signature of Registrant)

Subscribed and sworn to before me this 23 day of JANUARY, 1958

My commission expires JUNE 30 1961

*[Signature]*  
\_\_\_\_\_  
(Notary Public)

(SEAL)

**CERTIFICATE OF REGISTRATION**

STATE OF OREGON

County of Marion } ss

This is to certify that the foregoing Registration Statement was received in the office of the State Engineer on the 23 day of JANUARY, 1958, at 5:00 o'clock PM and has been duly recorded in said office in Book No. 5 of Registration Statements on page 912

Witness my hand this 7 day of May, 1958

*[Signature]*  
\_\_\_\_\_  
(State Engineer)

By \_\_\_\_\_  
(Deputy)