REGISTRATION NO. GR-942
CERTIFICATE NO. GR-915

# Registration Statement

## OF CLAIMANT OF RIGHT TO APPROPRIATE GROUND WATER

**(Under Chapter 708, Oregon Laws 1955.)**

**TO THE STATE ENGINEER OF OREGON:**

I, Harry N. and Louella M. Gleim,

of Route 1, Box 575, Talent, County of Jackson

State of Oregon, do hereby make application for a certificate of registration as evidence of a right to appropriate ground water.

1. **Source** from which water is withdrawn is Infiltration Trench
(Flowing well, pump well, infiltration trench, or tunnel)

2. **Location** is: 1½ miles south of Talent, Oregon
(Approximate distance and direction from nearest city or town);

and is more particularly described as follows:

(a) 325 feet North & 200 feet west from the SE corner of DLC No. 63
(Give distance and bearing to corner of section or other legal subdivision)

being within SW¼ SW¼ (Smallest legal subdivision) of Sec. 26, Twp. 38 S. (N. or S.), Rge. 1 W. (E. or W.)

or (b) within limits of recorded platted property, town or city:

in Lot ....., Block ..... of .....
(Name of plat or addition)

..... County of .....
(If within city or town, give name)

3. **Construction Work** was begun on 1940 (Date); was completed on 1940 (Date)

and the ground water claimed was first used for the purposes set out below on 1940 (Date);

since which time the water has been used continuously (Continuously or intermittently)

from 1940 (Date) to 1957 (Date)

4. **Quantity** of water claimed and used is 50 gallons per minute; 1.4 acre feet per year.

5. **Purpose or Purposes** for which water is used supplemental irrigation
(Domestic, irrigation, municipal, manufacturing, industrial, etc.)

6. **Description of Well:** Depth 12 feet. Type dug (Dug or drilled)

diameter 10'x70' [redacted]. Elevation of ground at well site 1700 (As near as known) feet, mean sea level.

Depth to water table 2.0 feet.

7. **Capacity of Well:** ..... g.p.m. with ..... feet drawdown.

..... g.p.m. with ..... feet drawdown.

Date of test .....

**If Flowing Well:** Measured discharge ..... g.p.m. on ..... (Date)

Shut-in pressure at ground surface ..... lbs. per sq. in. on ..... (Date)

Water is controlled by .....
(Cap, valve, etc.)

8. **Casing:** (Give diameter, commercial specifications and depth below ground surface of each casing size.)

..... inch diameter ..... none ..... from ..... to ..... feet

..... inch diameter ..... from ..... to ..... feet

..... inch diameter ..... from ..... to ..... feet

..... inch diameter ..... from ..... to ..... feet

Describe and show depth of shoe, plug, adapter, liner or other details: .....

9. **Perforated Casings or Screens:**

..... none ..... from ..... to .....
(Number per foot and size of perforations, or describe screen)

..... from ..... to .....

..... from ..... to .....

..... from ..... to .....

10. **Log of Well:** (Describe each stratum or formation clearly, indicate if water bearing, and give thickness and depth as indicated.)

| MATERIAL | Thickness (Feet) | Depth to Bottom (Feet) |
|---|---|---|
| clay loam | 7 | 5 |
| fine sand | 2 | 3 |
| gravel | 7 | 0 |

GR- 915 A

If log of well is not available, give name and address of driller. .....

11. **Infiltration Trench:** Covered or open open

Dimensions: Length 70 ft. Minimum depth 10 ft. Maximum depth 12 ft.

Bottom width 30 ft. Discharge 50 g.p.m. Date of test 1940

12. **Tunnel:** Type of lining .....

Dimensions: .....
(Length, course, and cross sectional size)

Position of water bearing stratum with reference to portal of tunnel .....

Log of tunnel: (Preceding table for log of well may be used if desired. Give footage from portal and character of materials, as pertinent.)

13. **Pumping Equipment:**

(a) Pump 1.5 inch centrifugal pump (Make, type and size) Capacity 50 g.p.m.

(b) Motor 2.0 H.P. electric motor (Type and horsepower)

14. Location of area irrigated or to be irrigated, or place of use if for purposes other than irrigation.

| Township North or South | Range E. or W. of Willamette Meridian | Section | Forty-acre Tract | Number Acres To Be Irrigated | Date of Reclamation |
|---|---|---|---|---|---|
| 30 S. | 1 W. | 26 | SW¼ SW¼ | 9.2 acres | 1940 |

15. If the ground water supply is supplemental to an existing water supply, identification of any application for a permit, permit, certificate or adjudicated right to appropriate water made or held by the registrant.

In the Rogue River Decree, Page 13, Col. 1 and 2 in the names of Beeson and Robison Irrigating Ditch.

GR-915 B

Township 38 S. Range 1 W., W.M.

North

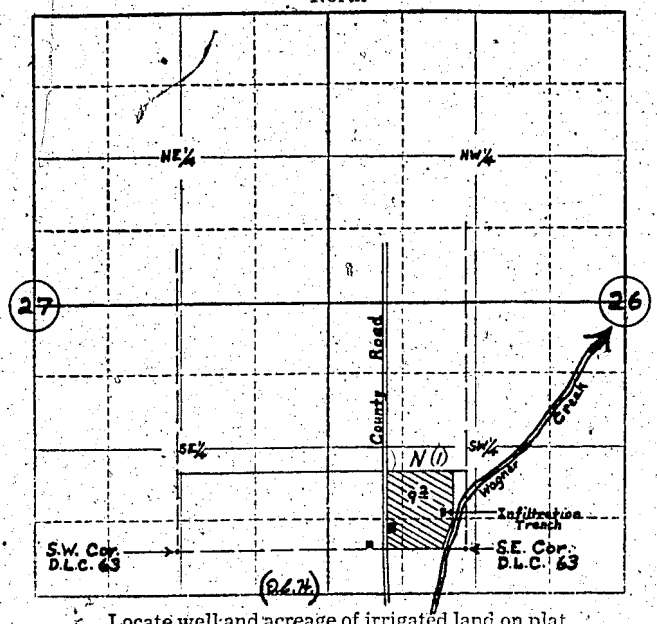


Locate well and acreage of irrigated land on plat.

Scale: 4" = 1 Mile

STATE OF OREGON
County of Jackson } ss.

I, Harry N. Kleim & Louella L. Kleim, being first duly sworn, do hereby certify that I have read the foregoing Registration Statement and that all of the items therein contained are true to the best of my knowledge and belief.

(Signature of Registrant)

Subscribed and sworn to before me this 11th day of January, 1958.

My commission expires Jan. 11, 1962

(Notary Public)

(SEAL)

## CERTIFICATE OF REGISTRATION

STATE OF OREGON
County of Marion } ss.

This is to certify that the foregoing Registration Statement was received in the office of the State Engineer on the ..... day of ....., 19..., at ..... o'clock ....M. and has been duly recorded in said office in Book No. 5 of Registration Statements on page 915.

~~Construction shall be completed by X-X-X-X-X-X-X-X-X-X, 19XX-X-X and the water completely applied to beneficial use by X-X-XX-X-X-X-X-X-X, 19XX-X-X-X~~

Witness my hand this 7 day of May, 1958

(State Engineer)

By .....
(Deputy)

GR-915 C