

Registration Statement

OF CLAIMANT OF RIGHT TO APPROPRIATE GROUND WATER

TO THE STATE ENGINEER OF OREGON:

I, Curly's Dairy, Inc.
of 1410 Fairgrounds Rd County of Marion
(Mailing address)
State of Oregon, do hereby make application for a certificate of registration as evidence of a right to appropriate ground water.

1. Source from which water is withdrawn is pump well #2
(Flowing well, pump well, infiltration trench, or tunnel)
2. Location is: in Salem, Oregon
(Approximate distance and direction from nearest city or town)

and is more particularly described as follows:

(a) 550 feet east & 1250 feet south from NW corner of Section 23
(Give distance and bearing to corner of section or other legal subdivision)
being within NW 1/4 of NW 1/4 of Sec. 23, Twp. 7S, Rge. 3W
(Smallest legal subdivision) (N. or S.) (E. or W.)
or (b) within limits of recorded platted property, town or city: Salem, Oregon
in Lot _____, Block 57 of North Salem Addition
Salem County of Marion
(If within city or town, give name) (Name of plat or addition)

3. Construction Work was begun on 9-20-41; was completed on 9-20-41
(Date) (Date)
and the ground water claimed was first used for the purposes set out below on 9-19-41
(Date)
since which time the water has been used continuously
(Continuously or Intermittently)
from 9-19-41 to JAN. 1958
(Date) (Date)

4. Quantity of water claimed and used is 45 gallons per minute; acre feet per year.

5. Purpose or Purposes for which water is used: Cooling of milk for retail sale
industrial use
(Domestic, irrigation, municipal, manufacturing, industrial, etc.)

6. Description of Well: Depth 112 feet. Type drilled
(Dug or drilled)
diameter 8 inches. Elevation of ground at well site 134 feet; mean sea level.
(As near as known)
Depth to water table 14 feet.

7. Capacity of Well: _____ g.p.m. with _____ feet drawdown.
_____ g.p.m. with _____ feet drawdown.

Date of test 12-20-57

If Flowing Well: Measured discharge _____ g.p.m. on _____
(Date)

Shut-in pressure at ground surface _____ lbs. per sq. in. on _____
(Date)

Water is controlled by _____
(Cap, valve, etc.)

8. **Casing:** (Give diameter, commercial specifications and depth below ground surface of each casing size.)

8	inch diameter	steel casing	from	0	to	1 1/2	feet
	inch diameter		from		to		feet
	inch diameter		from		to		feet
	inch diameter		from		to		feet

Describe and show depth of shoe, plug, adapter, liner or other details: _____

9. Perforated Casings or Screens:

yes 30 ft of Perforations from 82 to 112
(Number per foot and size of perforations, or describe screen) ✓
from to
from to
from to
from to

10. **Log of Well:** (Describe each stratum or formation clearly, indicate if water bearing, and give thickness and depth as indicated.)

[illegible]

If log of well is not available, give name and address of driller.

Heaven

Brooks, Oregon, Retired.

11. Infiltration Trench: Covered or open

Dimensions: Length _____, ft. Minimum depth _____, ft. Maximum depth _____, ft.

Bottom width ft. Discharge g.p.m. Date of test

12. Tunnel: Type of lining

Dimensions: (Length, course, and cross sectional size)

Position of water bearing stratum with reference to portal of tunnel

Log of tunnel: (Preceding table for log of well may be used, if desired. Give footage from portal and character of materials, as pertinent.)

- ### 13. Pumping Equipment:

(a) Pump Fairbanks Morse Jet pump Capacity 15 g.p.m.
(Make, type and size)


(b) Motor 3 phase 5 hp
(Type and horsepower)

14. Location of area irrigated or to be irrigated, or place of use if for purposes other than irrigation.

[illegible]

15. If the ground water supply is supplemental to an existing water supply, identification of any application for a permit, permit, certificate or adjudicated right to appropriate water made or held by the registrant.

Township 75. Range 34 W.M.
North

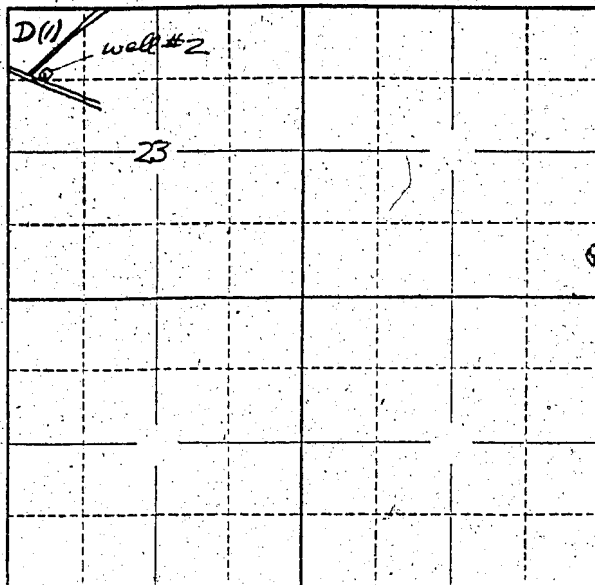

Locate well and acreage of irrigated land on plat.

Scale: 2" = 1 Mile

STATE OF OREGON

County of Marion } ss.

I, _____, being first duly sworn, do hereby certify that I have read the foregoing Registration Statement and that all of the items therein contained are true to the best of my knowledge and belief.

[Signature]
(Signature of Registrant)

Subscribed and sworn to before me this 12 day of June, 1958

My commission expires 12 June 1961

Wm. S. Bartholomew
(Notary Public)

(SEAL)

CERTIFICATE OF REGISTRATION

STATE OF OREGON

County of Marion } ss.

This is to certify that the foregoing Registration Statement was received in the office of the State Engineer on the 20 day of January, 1958, at 8:00 o'clock A.M. and has been duly recorded in said office in Book No. 5 of Registration Statements on page 916

Witness my hand this 7 day of May, 1958

[Signature]
(State Engineer)

By _____
(Deputy)

GR - 916 C