

Registration Statement

OF CLAIMANT OF RIGHT TO APPROPRIATE GROUND WATER

TO THE STATE ENGINEER OF OREGON:

I, Curly's Dairy, Inc.of 1410 Fairgrounds Rd
(Mailing address)County of MarionState of Oregon, do hereby make application for a certificate of registration as evidence of a right to appropriate ground water.1. Source from which water is withdrawn is pump well #1
(Flowing well, pump well, infiltration trench, or tunnel)2. Location is: in Salem, Oregon
(Approximate distance and direction from nearest city or town)

and is more particularly described as follows:

(a) 650 feet east and 1250 feet south from NW corner of Section 23
(Give distance and bearing to corner of section or other legal subdivision)being within NW 1/4 of NW 1/4 of Sec. 23 Twp. 7S Rge. 3W
(Smallest legal subdivision) (N, or S.) (E, or W.)or (b) within limits of recorded platted property, town or city: Salem, Oregonin Lot 0, Block 51 of North Salem add.
(Name of plat or addition)Salem County of Marion
(If within city or town, give name)3. Construction Work was begun on July 10th 1928; was completed on July 19th 1928
(Date) (Date)and the ground water claimed was first used for the purposes set out below on Dec. 25th 1928
(Date)since which time the water has been used continuously
(Continuously or intermittently)from Dec. 25th 1928 to Nov. 1957
(Date) (Date)4. Quantity of water claimed and used is 27 gallons per minute; _____ acre feet per year.5. Purpose or Purposes for which water is used Cooling Milk

(Domestic, irrigation, municipal, manufacturing, industrial, etc.)

6. Description of Well: Depth 86 feet. Type Drilled

(Dug or drilled)

diameter 10 inches. Elevation of ground at well site 184 feet, mean sea level.
(As near as known)Depth to water table 14 feet.7. Capacity of Well: 27 g.p.m. with _____ feet drawdown.

_____ g.p.m. with _____ feet drawdown.

Date of test 12-20-57If Flowing Well: Measured discharge _____ g.p.m. on _____
(Date)Shut-in pressure at ground surface _____ lbs. per sq. in. on _____
(Date)Water is controlled by _____
(Cap, valve, etc.)

10	inch diameter	Steel casing	from	0	to	86	feet
	inch diameter		from	0	to		feet
	inch diameter		from		to		feet
	inch diameter		from		to		feet

9. Perforated Casings or Screens:

..... from to

..... from to

..... from to

[illegible]

Harvey Evans

- Bottom width ft. Discharge g.p.m. Date of test

- ### Position of water bearing stratum with reference to portal of tunnel


13. Pumping Equipment:

- (b) Motor 3 phase 3hp (Type and horsepower)

- [illegible]

- GR-917B

Township 7S Range 3W W.M.
North

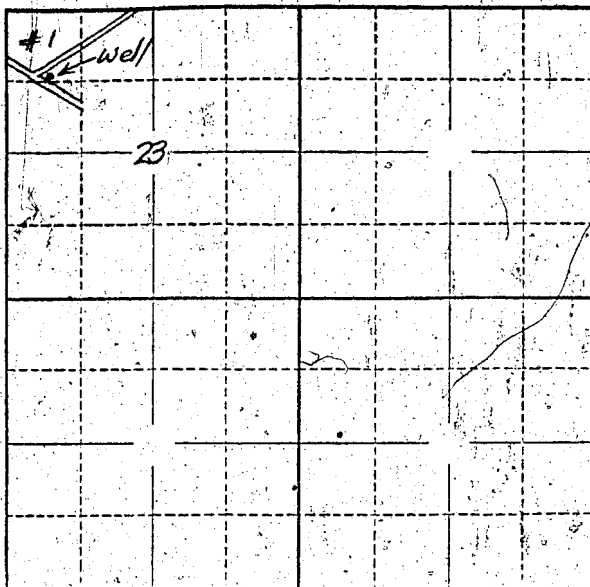

Locate well and acreage of irrigated land on plat.

Scale: 2" = 1 Mile

STATE OF OREGON

County of Marion

SS.

I, _____, being first duly sworn, do hereby certify that I have read the foregoing Registration Statement and that all of the items therein contained are true to the best of my knowledge and belief.

Wm. S. Bartholomew
(Signature of Registrant)

Subscribed and sworn to before me this 18th day of Jan, 1958

My commission expires 12 June 1961

Wm. S. Bartholomew
(Notary Public)

(SEAL)

CERTIFICATE OF REGISTRATION

STATE OF OREGON

County of Marion

SS.

This is to certify that the foregoing Registration Statement was received in the office of the State Engineer on the 28 day of January, 1958 at 8:00 o'clock A.M. and has been duly recorded in said office in Book No. 5 of Registration Statements on page 917

Witness my hand this 7 day of May, 1958

Elmer A. Williams
(State Engineer)

By

(Deputy)

GR - 917 C