

# Registration Statement

RECEIVED  
MAY 27 1958  
STATE ENGINEER  
SALEM, OREGON

## OF CLAIMANT OF RIGHT TO APPROPRIATE GROUND WATER

(Under Chapter 708, Oregon Laws 1955.)

TO THE STATE ENGINEER OF OREGON:

I, Rudolf Scheerer  
of Rt 3 Box 291 Hillsboro County of Washington

State of Oregon, do hereby make application for a certificate of registration as evidence of a right to appropriate ground water.

1. Source from which water is withdrawn is Pump well #1  
(Flowing well, pump well, infiltration trench, or tunnel)
2. Location is: 4 1/2 Miles N. of Hillsboro  
(Approximate distance and direction from nearest city or town)

and is more particularly described as follows:

(a) 360 feet south & 175 feet west from NE corner of Section 18, T1N, R2W  
(Give distance and bearing to corner of section or other legal subdivision)  
being within NE 1/4 of NE 1/4 of Sec. 18, Twp. 1 N., Rge. 2 W.  
(Smallest legal subdivision) (N. or S.) (E. or W.)

or (b) within limits of recorded platted property, town or city: N 13° 51' W from SE Cor. Lot 1  
in Lot: 1, Block of Freeman Acres (Part of John Paul D.L.C.)  
(Name of plat or addition)  
Washington County of Washington  
(If within city or town, give name)

3. Construction Work was begun on June 1954; was completed on July 1954  
(Date) (Date)  
and the ground water claimed was first used for the purposes set out below on July 1954  
(Date)  
since which time the water has been used Continuously  
(Continuously or intermittently)  
from July 1954 to Present  
(Date) (Date)

4. Quantity of water claimed and used is 18 gallons per minute; 1 acre feet per year.

5. Purpose or Purposes for which water is used Irrigation & Domestic  
Domestic, irrigation  
(Domestic, irrigation, municipal, manufacturing, industrial, etc.)

6. Description of Well: Depth 16.4 feet. Type Drilled  
(Dug or drilled)  
diameter 6 inches. Elevation of ground at well site 191 feet, mean sea level.  
(As near as known)  
Depth to water table 12 feet.

7. Capacity of Well: \_\_\_\_\_ g.p.m. with \_\_\_\_\_ feet drawdown.  
\_\_\_\_\_ g.p.m. with \_\_\_\_\_ feet drawdown.

Date of test \_\_\_\_\_

If Flowing Well: Measured discharge \_\_\_\_\_ g.p.m. on \_\_\_\_\_  
(Date)

Shut-in pressure at ground surface \_\_\_\_\_ lbs. per sq. in. on \_\_\_\_\_  
(Date)

Water is controlled by \_\_\_\_\_  
(Cap, valve, etc.)

8. Casing: (Give diameter, commercial specifications and depth below ground surface of each casing size.)

6 inch diameter *steel casing* from 1' to 16.4' feet  
inch diameter ..... from ..... to ..... feet  
inch diameter ..... from ..... to ..... feet  
inch diameter ..... from ..... to ..... feet

Describe and show depth of shoe, plug, adapter, liner or other details:

9. Perforated Casings or Screens:

*unk* from ..... to .....  
(Number per foot and size of perforations, or describe screen)  
from ..... to .....  
from ..... to .....  
from ..... to .....

10. Log of Well: (Describe each stratum or formation clearly, indicate if water bearing, and give thickness and depth as indicated.)

MATERIAL	Thickness (Feet)	Depth to Bottom (Feet)
<i>unk</i>		

If log of well is not available, give name and address of driller. A. J. Gavnt Aloha

11. Infiltration Trench: Covered or open .....  
Dimensions: Length ..... ft. Minimum depth ..... ft. Maximum depth ..... ft.  
Bottom width ..... ft. Discharge ..... g.p.m. Date of test .....

12. Tunnel: Type of lining .....  
Dimensions: .....  
(Length, course, and cross sectional size)  
Position of water bearing stratum with reference to portal of tunnel .....

Log of tunnel: (Preceding table for log of well may be used, if desired. Give footage from portal and character of materials, as pertinent.)


13. Pumping Equipment:  
(a) Pump Bar Kiley <sup>Model 288-80</sup> ~~Bar Kiley~~ 1" discharge Capacity 1.8 g.p.m.  
(Make, type and size)  
(b) Motor 2 Horse E.L.C.  
(Type and horsepower)

14. Location of area irrigated or to be irrigated, or place of use if for purposes other than irrigation.

Township North or South	Range E. or W. of Willamette Meridian	Section	Forty-acre Tract	Number Acres To Be Irrigated	Date of Reclamation
<u>T. 1 N.</u>	<u>R. 2 W.</u>	<u>18</u>	<u>NE 1/4 NE 1/4</u>	<u>10</u>	<u>1951</u>

15. If the ground water supply is supplemental to an existing water supply, identification of any application for a permit, permit, certificate or adjudicated right to appropriate water made or held by the registrant.

Township 1 N Range 2 W, W.M.  
North

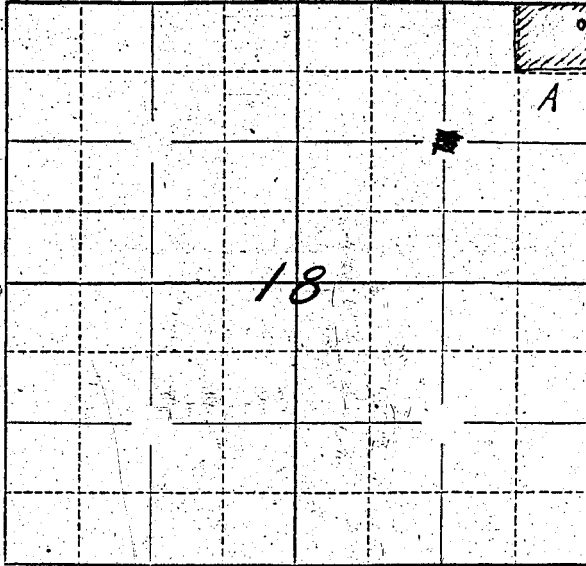

Locate well and acreage of irrigated land on plat.

Scale:  $\frac{1}{4}$ " = 1 Mile

STATE OF OREGON

County of Washington } ss.

I, Paul G. Green, being first duly sworn, do hereby certify that I have read the foregoing Registration Statement and that all of the items therein contained are true to the best of my knowledge and belief.

Paul G. Green  
(Signature of Registrant)

Subscribed and sworn to before me this 29 day of January, 1958

My commission expires Jan 11, 1959 Shirley M. [unclear]  
(Notary Public)

(SEAL)

CERTIFICATE OF REGISTRATION

STATE OF OREGON

County of Marion } ss.

This is to certify that the foregoing Registration Statement was received in the office of the State Engineer on the 29th day of January, 1958, at 8:00 o'clock A.M. and has been duly recorded in said office in Book No. 11 of Registration Statements on page GR-2443

~~Construction shall be completed by 18 and the water completely applied to beneficial use by 18~~

Witness my hand this 16th day of March, 1959

Lewis A. [unclear]  
(State Engineer)

\$25.00

By \_\_\_\_\_ (Deputy)

GR-2443