REGISTRATION NO. GR-9[illegible]

CERTIFICATE NO. GR-921

Registration Statement

OF CLAIMANT OF RIGHT TO APPROPRIATE GROUND WATER

(Under Chapter 708, Oregon Laws 1955.)

TO THE STATE ENGINEER OF OREGON:

I, Alfred B. Teufel

of 11414 N. W. Cornell Rd. Portland County of Washington

State of Oregon, do hereby make application for a certificate of registration as evidence of a right to appropriate ground water.

1. **Source** from which water is withdrawn is Pump Well
(Flowing well, pump well, infiltration trench, or tunnel)

2. **Location is:** 1/2 miles East of Cedar Mill
(Approximate distance and direction from nearest city or town)

and is more particularly described as follows:

(a) About 600' west, 200' south of N. E. Corner of Sec. 34
(Give distance and bearing to corner of section or other legal subdivision)

being within N. E. 1/4 of N. E. 1/4 (Smallest legal subdivision) of Sec. 34, Twp. 1N (N. or S.), Rge. 1 W (E. or W.)

or (b) within limits of recorded platted property, town or city:

in Lot ....., Block ..... of ..... (Name of plat or addition)

..... (If within city or town, give name) County of .....

3. **Construction Work** was begun on 1935 (Date); was completed on 1935 (Date)

and the ground water claimed was first used for the purposes set out below on 1935 (Date)

since which time the water has been used continuously (Continuously or intermittently)

from 1935 (Date) to 1956 (Date)

4. **Quantity** of water claimed and used is 100 gallons per minute; 25 acre feet per year.

5. **Purpose or Purposes** for which water is used Nursery irrigation, ~~general farm and domestic~~
(Domestic, irrigation, municipal, manufacturing, industrial, etc.)

6. **Description of Well:** Depth 200 feet. Type Drilled (Dug or drilled)

diameter 6" inches. Elevation of ground at well site [redacted] 460 (As near as known) feet, mean sea level.

Depth to water table 140' feet.

7. **Capacity of Well:** 100 g.p.m. with 0 feet drawdown.

..... g.p.m. with ..... feet drawdown.

Date of test [redacted]945

If Flowing We[redacted]d discharge ..... g.p.m. on ..... (Date)

Shut-in pressur[redacted]d surface ..... lbs. per sq. in. on ..... (Date)

Water is controll[redacted] by ..... (Cap, valve, etc.)

8. **Casing:** (Give diameter, commercial specifications and depth below ground surface of each casing size.)

6 inch diameter Steel Casing from 0 to 200' feet

inch diameter from to feet

inch diameter from to feet

inch diameter from to feet

Describe and show depth of shoe, plug, adapter, liner or other details:

9. **Perforated Casings or Screens:**

No record from to

(Number per foot and size of perforations, or describe screen)

from to

from to

from to

10. **Log of Well:** (Describe each stratum or formation clearly, indicate if water bearing, and give thickness and depth as indicated.)

MATERIAL	Thickness (Feet)	Depth to Bottom (Feet)
No record		

GR-921 A

If log of well is not available, give name and address of driller. Strasser Drilling Co.

11. **Infiltration Trench:** Covered or open .....

Dimensions: Length ..... ft. Minimum depth ..... ft. Maximum depth ..... ft.

Bottom width ..... ft. Discharge ..... g.p.m. Date of test .....

12. **Tunnel:** Type of lining .....

Dimensions: .....
(Length, course, and cross sectional size)

Position of water bearing stratum with reference to portal of tunnel .....

Log of tunnel: (Preceding table for log of well may be used, if desired. Give footage from portal and character of materials, as pertinent.)

13. **Pumping Equipment:**

(a) Pump Peerless Turbine (Make, type and size) Capacity 100 g.p.m. at 100 lbs. pressur

(b) Motor 15 HP 3 Ph. vertical (Type and horsepower)

14. Location of area irrigated or to be irrigated, or place of use if for purposes other than irrigation.

Township North or South	Range E. or W. of Willamette Meridian	Section	Forty-acre Tract	Number Acres To Be Irrigated	Date of Reclamation
1 N	1W	34	NE ¼ of NE ¼	20a.	1950

The water in this well only comes up 60' but we can not lower the water level with a 100 g.p.m. 15 HP turbine pump.

This well is located about 600' West and 200' South of the N. E. Corner of Sec. 34 T1N 1W WM Washington County, Ore.

We have a total of 100 acres but would not irrigate over 20 acres.

15. If the ground water supply is supplemental to an existing water supply, identification of any application for a permit, permit, certificate or adjudicated right to appropriate water made or held by the registrant.

.....

GR-921 B

Township 1N Range 1W, W.M.

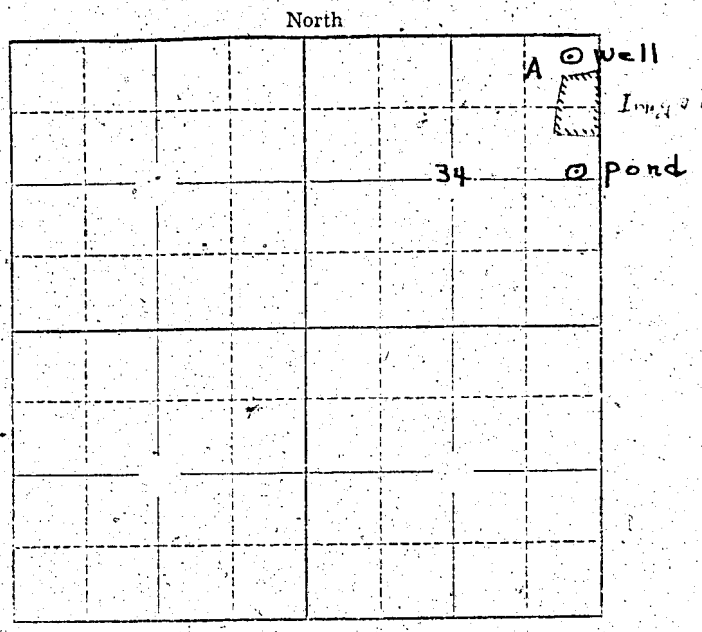

Locate well and acreage of irrigated land on plat.

Scale: 2" = 1 Mile

STATE OF OREGON
County of Washington } ss.


(Signature of Registrant)

Subscribed and sworn to before me this 14th day of January, 1958.

My commission expires August 27, 1958 [illegible]
(Notary Public)

(SEAL)

CERTIFICATE OF REGISTRATION

STATE OF OREGON
County of Marion } ss.

This is to certify that the foregoing Registration Statement was received in the office of the State Engineer on the 30 day of January, 1958, at 8:00 o'clock A.M. and has been duly recorded in said office in Book No. 5 of Registration Statements on page 921.

~~Construction shall be completed by x-x-x-x-x-x-x-x-x-19-x-x and the water completely applied to x x-x-x-x-x-x-x-x-x-x-x-x-x-x-x-x-x-x-x-19-x-x-x~~

Witness my hand this 7 day of May, 1958.

[illegible]
(State Engineer)

By
(Deputy)

GR-921 C