

Registration Statement

OF CLAIMANT OF RIGHT TO APPROPRIATE GROUND WATER

TO THE STATE ENGINEER OF OREGON:

I, Clay Whitaker

of Rt. 2 Box 359, Eugene County of Lane

State of Oregon, do hereby make application for a certificate of registration as evidence of a right to appropriate ground water.

1. Source from which water is withdrawn is pump well # 2
(Flowing well, pump well, infiltration trench, or tunnel)
2. Location is: 1/2 mile West of Coburg
(Approximate distance and direction from nearest city or town)

and is more particularly described as follows:

(a) Well bears S. 1° 36' W. 823' from the S.W. Corner of the Issac Van Dwyne D.L.C.
(Give distance and bearing to corner of section or other legal subdivision)

being within S.E. 4 OF N.E. 4 of Sec. 32, Twp. 16 S., Rge. 3 W.
(Smallest legal subdivision) (N. or S.) (E. or W.)

or (b) within limits of recorded platted property, town or city:
in Lot _____, Block _____ of _____
(Name of plat or addition)

County of _____
(If within city or town, give name)

3. Construction Work was begun on 1932; was completed on 1932
(Date) (Date)

and the ground water claimed was first used for the purposes set out below on 1932
(Date)

since which time the water has been used Continuously
(Continuously or intermittently)

from 1932 to 1958
(Date) (Date)

4. Quantity of water claimed and used is 150 gallons per minute; 9.0 acre feet per year.

5. Purpose or Purposes for which water is used Irrigation
(Domestic, irrigation, municipal, manufacturing, industrial, etc.)

6. Description of Well: Depth 12 feet. Type Driven
(Dug or drilled)

diameter 3 - 2 1/2 inches. Elevation of ground at well site 380 feet, mean sea level.
(As near as known)

Depth to water table 2 feet.

7. Capacity of Well: 150 g.p.m. with 6 feet drawdown.

_____ g.p.m. with _____ feet drawdown.


Date of test August 1954

If Flowing Well: Measured discharge _____ g.p.m. on _____
(Date)

Shut-in pressure at ground surface _____ lbs. per sq. in. on _____
(Date)

Water is controlled by _____
(Cap, valve, etc.)

Township 16S Range 34 W.M.
North

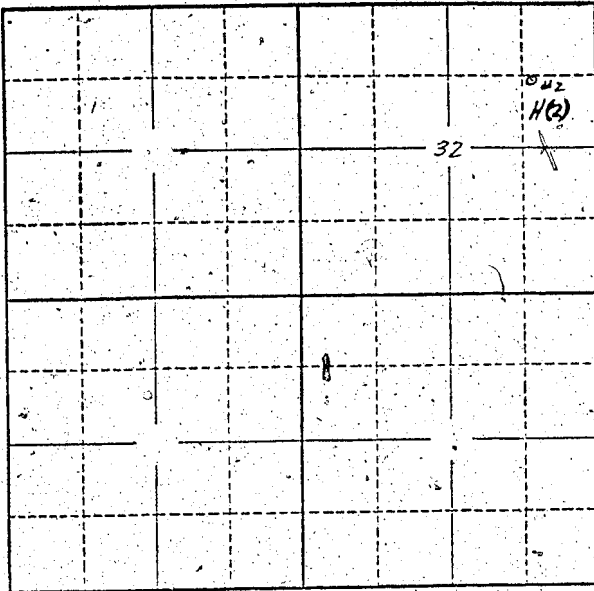

Locate well and acreage of irrigated-land on plat.
Scale: 2" = 1 Mile.

STATE OF OREGON

County of Lane } ss.

I, Clay Whitaker, being first duly sworn, do hereby certify that I have read the foregoing Registration Statement and that all of the items therein contained are true to the best of my knowledge and belief.

Clay Whitaker
(Signature of Registrant)

Subscribed and sworn to before me this 3rd day of February, 1958

My commission expires June 12th 1961

Wm. S. Bartholomew
(Notary Public)

(SEAL)

CERTIFICATE OF REGISTRATION

STATE OF OREGON

County of Marion } ss.

This is to certify that the foregoing Registration Statement was received in the office of the State Engineer on the 3 day of February, 1958, at 8:00 o'clock A. M. and has been duly recorded in said office in Book No. 5 of Registration Statements on page 926

Witness my hand this 7 day of May, 1958

Laura A. Stanley
(State Engineer)

By _____
(Deputy)