

Registration Statement

OF CLAIMANT OF RIGHT TO APPROPRIATE GROUND WATER

TO THE STATE ENGINEER OF OREGON:

I, Clay Whitaker

of Rt. 2 Box 359, Eugene County of Lane

State of OREGON, do hereby make application for a certificate of registration as evidence of a right to appropriate ground water.

1. Source from which water is withdrawn is Pump Well #3
(Flowing well, pump well, infiltration trench, or tunnel)

2. Location is: 1/4 of a mile west of Coburg
(Approximate distance and direction from nearest city or town)

and is more particularly described as follows:

(a) Well bears S. 60° 43' E. from the S.W. Corner of the Issac Van Duyne
(Give distance and bearing to corner of section or other legal subdivision) D.L.C.

being within N.E. 1/4 of N.E. 1/4 of Sec. 32, Twp. 16 S., Rge. 23 W.
(Smallest legal subdivision) (N. or S.) (E. or W.)

or (b) within limits of recorded platted property, town or city:

In Lot _____, Block _____ of _____
(Name of plat or addition)

County of _____
(If within city or town, give name)

3. Construction Work was begun on 1940; was completed on 1940
(Date) (Date)

and the ground water claimed was first used for the purposes set out below on 1940
(Date)

since which time the water has been used Continuously
(Continuously or intermittently)

from 1940 to 1958
(Date) (Date)

4. Quantity of water claimed and used is 150 gallons per minute; 9.0 acre feet per year.

5. Purpose or Purposes for which water is used Irrigation

(Domestic, irrigation, municipal, manufacturing, industrial, etc.)

6. Description of Well: Depth 18 feet. Type Driven

(Dug or drilled)

diameter 4 inches. Elevation of ground at well site 385 feet, mean sea level.
(As near as known)

Depth to water table 6 feet.

7. Capacity of Well: 200 g.p.m. with 6 feet drawdown.

_____ g.p.m. with _____ feet drawdown.

Date of test August 1940

If Flowing Well: Measured discharge _____ g.p.m. on _____

(Date)

Shut-in pressure at ground surface _____ lbs. per sq. in. on _____

(Date)

Water is controlled by _____

(Cap, valve, etc.)

8. Casing: (Give diameter, commercial specifications and depth below ground surface of each casing size.)

4 inch diameter **Steel pipe** from 0 to 18 feet
 inch diameter from to feet
 inch diameter from to feet
 inch diameter from to feet

Describe and show depth of shoe, plug, adapter, liner or other details:

9. Perforated Casings or Screens:

1/2" X 3" Slits from 14' to 18'
(Number per foot and size of perforations, or describe screen)

from to
 from to
 from to

10. Log of Well: (Describe each stratum or formation clearly, indicate if water bearing, and give thickness and depth as indicated.)

MATERIAL	Thickness (Feet)	Depth to Bottom (Feet)
Sandy loam	4	4
Medium sized gravel	14	18

If log of well is not available, give name and address of driller.

11. Infiltration Trench: Covered or open
 Dimensions: Length ft. Minimum depth ft. Maximum depth ft.

Bottom width ft. Discharge g.p.m. Date of test

12. Tunnel: Type of lining

Dimensions:
(Length, course, and cross sectional size)

Position of water bearing stratum with reference to portal of tunnel

Log of tunnel: (Preceding table for log of well may be used, if desired. Give footage from portal and character of materials, as pertinent.)

13. Pumping Equipment:

(a) Pump 2" Centrifugal Capacity 150 g.p.m.
(Make, type and size)

(b) Motor 9 h.p. Gas motor
(Type and horsepower)

14. Location of area irrigated or to be irrigated, or place of use if for purposes other than irrigation.


Township North or South	Range E. or W. of Willamette Meridian	Section	Forty-acre Tract	Number Acres To Be Irrigated	Date of Reclamation
T.16.S.	R.3.W.	32	N.E. 1/4 of N.E. 1/4	6	

15. If the ground water supply is supplemental to an existing water supply, identification of any application for a permit, permit, certificate or adjudicated right to appropriate water made or held by the registrant.

.....

.....

Township 165 Range 34 W.M.
North

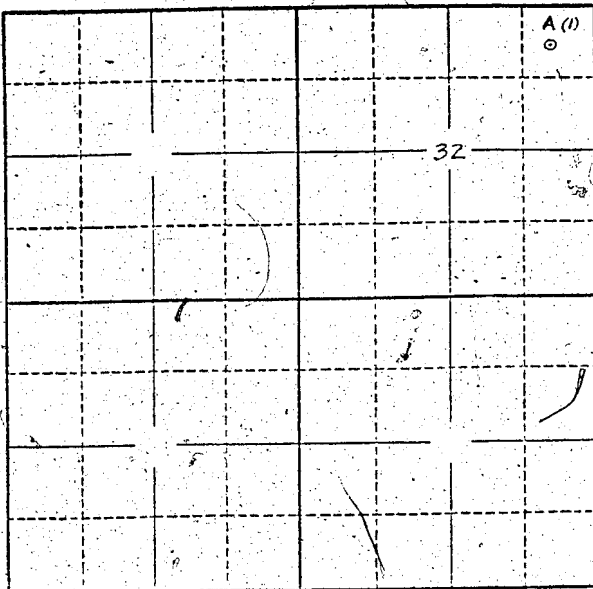

Locate well and acreage of irrigated land on plat.
Scale: 2" = 1 Mile.

STATE OF OREGON

County of Lane

ss.

I, Blay Whitaker, being first duly sworn, do hereby certify that I have read the foregoing Registration Statement and that all of the items therein contained are true to the best of my knowledge and belief.

Blay Whitaker
(Signature of Registrant)

Subscribed and sworn to before me this 3rd day of February, 1958

My commission expires June 12th, 1961

Wm. S. Bartholomew
(Notary Public)

(SEAL)

CERTIFICATE OF REGISTRATION

STATE OF OREGON

County of Marion

ss.

This is to certify that the foregoing Registration Statement was received in the office of the State Engineer on the 3 day of February, 1958, at 8:00 o'clock A.M. and has been duly recorded in said office in Book No. 5 of Registration Statements on page 927

Witness my hand this 7 day of May, 1958

Leora A. Stanley
(State Engineer)

By _____
(Deputy)