

Registration Statement

OF CLAIMANT OF RIGHT TO APPROPRIATE GROUND WATER

TO THE STATE ENGINEER OF OREGON:

I, Lawrence A. Hercher

of Box 14, Dillard, Oregon County of Douglas

(Mailing address)

State of Oregon, do hereby make application for a certificate of registration as evidence of a right to appropriate ground water.

1. Source from which water is withdrawn is Pump well
(Flowing well, pump well, infiltration trench, or tunnel)

2. Location is: in Dillard, Oregon
(Approximate distance and direction from nearest city or town)

and is more particularly described as follows:

(a) 36 rods East, 85 rods North of center of Sec. 29
(Give distance and bearing to corner of section or other legal subdivision)
being within N.W. 1/4 of quarter of Sec. 29, Twp. 28 S., Rge. 6 East
(Smallest legal subdivision) (N. or S.) (E. of W.)

or (b) within limits of recorded platted property, town or city:

in Lot _____, Block _____ of _____
(Name of plat or addition)

County of _____
(If within city or town, give name)

3. Construction Work was begun on 1925; was completed on 1927
(Date) (Date)

and the ground water claimed was first used for the purposes set out below on 1930

since which time the water has been used irrigation
intermittently, seasonally,
(Continuously or Intermittently)

from 1930 to 1958
(Date) (Date)

4. Quantity of water claimed and used is 25 gallons per minute; _____ acre
feet per year.

5. Purpose or Purposes for which water is used irrigation use
(Domestic, irrigation, municipal, manufacturing, industrial, etc.)

6. Description of Well: Depth 21.5 feet. Type DUG
(Dug or drilled)

diameter 40 inches. Elevation of ground at well site 525 feet, mean sea level.
(As near as known)

Depth to water table 17 feet.

7. Capacity of Well: 25 g.p.m. with 1- feet drawdown;

_____ g.p.m. with _____ feet drawdown.

Date of test Aug. 29, 1957


If Flowing Well: Measured discharge _____ g.p.m. on _____ (Date)

Shut-in pressure at ground surface _____ lbs. per sq. in. on _____ (Date)

Water is controlled by _____
(Cap, valve, etc.)

Township 28 S. Range 6 W., W.M.

North

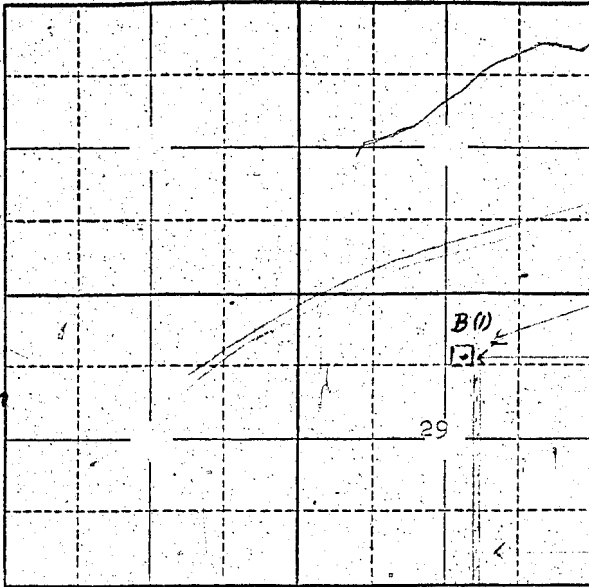

Locate well and acreage of irrigated land on plat.

Scale: 2" = 1 Mile

STATE OF OREGON

County of Douglas } ss.

I, Lawrence A. Hercher, being first duly sworn, do hereby certify that I have read the foregoing Registration Statement and that all of the items therein contained are true to the best of my knowledge and belief.

Lawrence A. Hercher
(Signature of Registrant)

Subscribed and sworn to before me this 31st day of January, 1958.

My commission expires Aug 21, 1960

W. C. [unclear]
(Notary Public)

(SEAL)

CERTIFICATE OF REGISTRATION

STATE OF OREGON

County of Marion } ss.

This is to certify that the foregoing Registration Statement was received in the office of the State Engineer on the 30 day of February, 1958, at 5:30 o'clock PM and has been duly recorded in said office in Book No. 5 of Registration Statements on page 928.

Witness my hand this 7 day of May, 1958.

Lawrence A. Stanley
(State Engineer)

By _____
(Deputy)