

Registration Statement

OF CLAIMANT OF RIGHT TO APPROPRIATE GROUND WATER

TO THE STATE ENGINEER OF OREGON:

I, Ralph E. Robertson
of Postal Box 28817, County of Marion
(Mailing address)

State of Oregon, do hereby make application for a certificate of registration as evidence of a right to appropriate ground water.

1. Source from which water is withdrawn is Pump well #1
(Flowing well, pump well, infiltration trench, or tunnel)
2. Location is: 2 miles N.W. of Marion, Oregon
(Approximate distance and direction from nearest city or town)

and is more particularly described as follows:

(a) 1200 feet north & 350 feet west from SE corner of Section 20
(Give distance and bearing to corner of section or other legal subdivision)
being within SE 1/4 of SE 1/4 of Sec. 20, Twp. 9S, Rge. 2W
(Smallest legal subdivision) (N or S) (E or W)

or (b) within limits of recorded platted property, town or city: _____

in Lot _____, Block _____ of _____
(Name of plat or addition)

County of _____
(If within city or town, give name)

3. Construction Work was begun on Oct 1 - 1953, was completed on Oct 10 - 1953
(Date) (Date)
and the ground water claimed was first used for the purposes set out below on May 1, 1954
(Date)
since which time the water has been used intermittently
(Continuously) or Intermittently)
from May 1 - 1954 to Feb 1 - 1958
(Date) (Date)

4. Quantity of water claimed and used is 90 gallons per minute; _____ acre feet per year.

5. Purpose or Purposes for which water is used irrigation of pasture & crops
Domestic use
(Domestic, irrigation, municipal, manufacturing, industrial, etc.)

6. Description of Well: Depth 81 feet. Type Dug
(Dug or drilled)
diameter 6 inches. Elevation of ground at well site 375 feet, mean sea level.
(As near as known)
Depth to water table 6 feet. Summer


7. Capacity of Well: 120 g.p.m. with 8 feet drawdown.
_____ g.p.m. with _____ feet drawdown.
Date of test: Oct 1 - 1953

If Flowing Well: Measured discharge 10 g.p.m. on During Winter Season
(Date)

Shut-in pressure at ground surface _____ lbs. per sq. in. on _____
(Date)

Water is controlled by None
(Cap. valve, etc.)

Township 9S Range 2W, W.M.
North

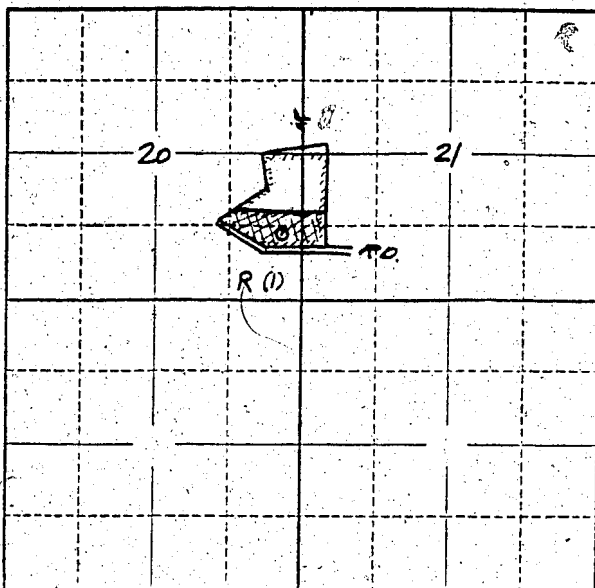

Locate well and acreage of irrigated land on plat.

Scale: 2" = 1 Mile

STATE OF OREGON

County of Marion } ss.

I, _____, being first duly sworn, do hereby certify that I have read the foregoing Registration Statement and that all of the items therein contained are true to the best of my knowledge and belief.

Gale E. Robertson
(Signature of Registrant)

Subscribed and sworn to before me this 5th day of February, 1958.

My commission expires 12th June 1961 Wm. S. Bartholomew
(Notary Public)

(SEAL)

CERTIFICATE OF REGISTRATION

STATE OF OREGON }
County of Marion } ss.

This is to certify that the foregoing Registration Statement was received in the office of the State Engineer on the 5 day of February, 1958, at 1:00 o'clock P.M. and has been duly recorded in said office in Book No. 5 of Registration Statements on page 933.

Witness my hand this 7 day of May, 1958.

Lewis A. Stanley
(State Engineer)

By _____
(Deputy)